


**RESURVEY AND SUBDIVISION**  
of  
**SECTION 32, T. 36 S., R. 4 W., W.M.**  
for  
**DEARMOND BROS. LUMBER CO.**  
**ROGUE RIVER, OREGON**  
Scale: 1 in. = 1000 ft. April 26, 1957

Sec Cor.

Found:

- 3/4" I. Pipe below surface of road
- B. Oak sprouts 516 1/2' W 318 lks.
- U.S.F.S. Location poster identifies corner
- Nearby resident states that pipe has been used for corner for 15 yrs.

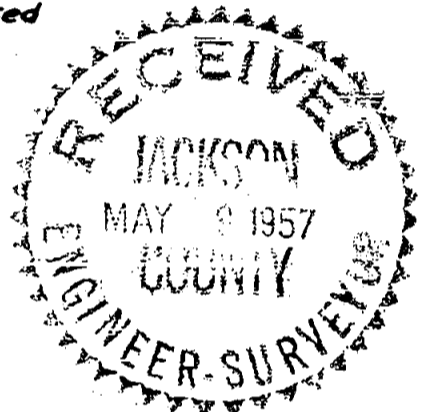

30 29  
31 32

1/4 Sec. Cor.

Set 1/2" axle at proportional distance mkd RE 3024 in mound of stone 2ft. at base 18 in. high

Scribed:

- 12" Pine N 64° W 20.6 ft.
- mkd 1/4 S 31 RE 3024 BT
- 10" B. Oak N 30° E 50.0 ft.
- mkd. 1/4 S 32 RE 3024 BT

N 00° 45' 1" E  
5299.6

2649.0

31 32

N 88° 05' 1" E  
NOT CHAINED

32 33

1/4 Sec Cor. Found:

- 24" B. Oak 579° E 50 lks.
- 36" B. Oak. N 65 1/2° W 77 lks.

Sec. Cor. Found:

- 24" B. Oak S 13° W 83 lks.
- blaze chopped out - scribing destroyed.
- 30" B. Oak East 108 lks.
- blazed for line tree with two original blazes
- 26" Pine N 06° E
- mkd with brass tag "CS JRW"

Set: 24" x 12" x 6" stone mkd with 5 notches on East

Scribed:

- 16" Y. Pine N 44° W 52.8 ft.
- mkd. S 31 RE 3024 BT
- 26" Y. Pine N 06° E 41.7 ft.
- mkd. S 32 BT beside brass tag
- 8" B. Oak S 47° E 32.7 ft.
- mkd. S 5 RE 3024 BT
- 24" B. Oak S 13° W 83 lks.
- mkd. S 6 BT between chopped out blazes

2649.0

31 32



Note:

Survey executed with Leupold Alta Transit and 200 foot steel tape. Distances measured on the slope and corrected to horizontal with alinometer in good adjustment. Bearings from solar observation. The purpose of the survey was to establish the south line of the NW 1/4 which was blazed and the blazes painted red.