


Survey For
TOM VELLA
 Lots 1&2 Blk. 6
 Central Point, Ore.
 By: M.E. Boyden
 Apr. 1957.

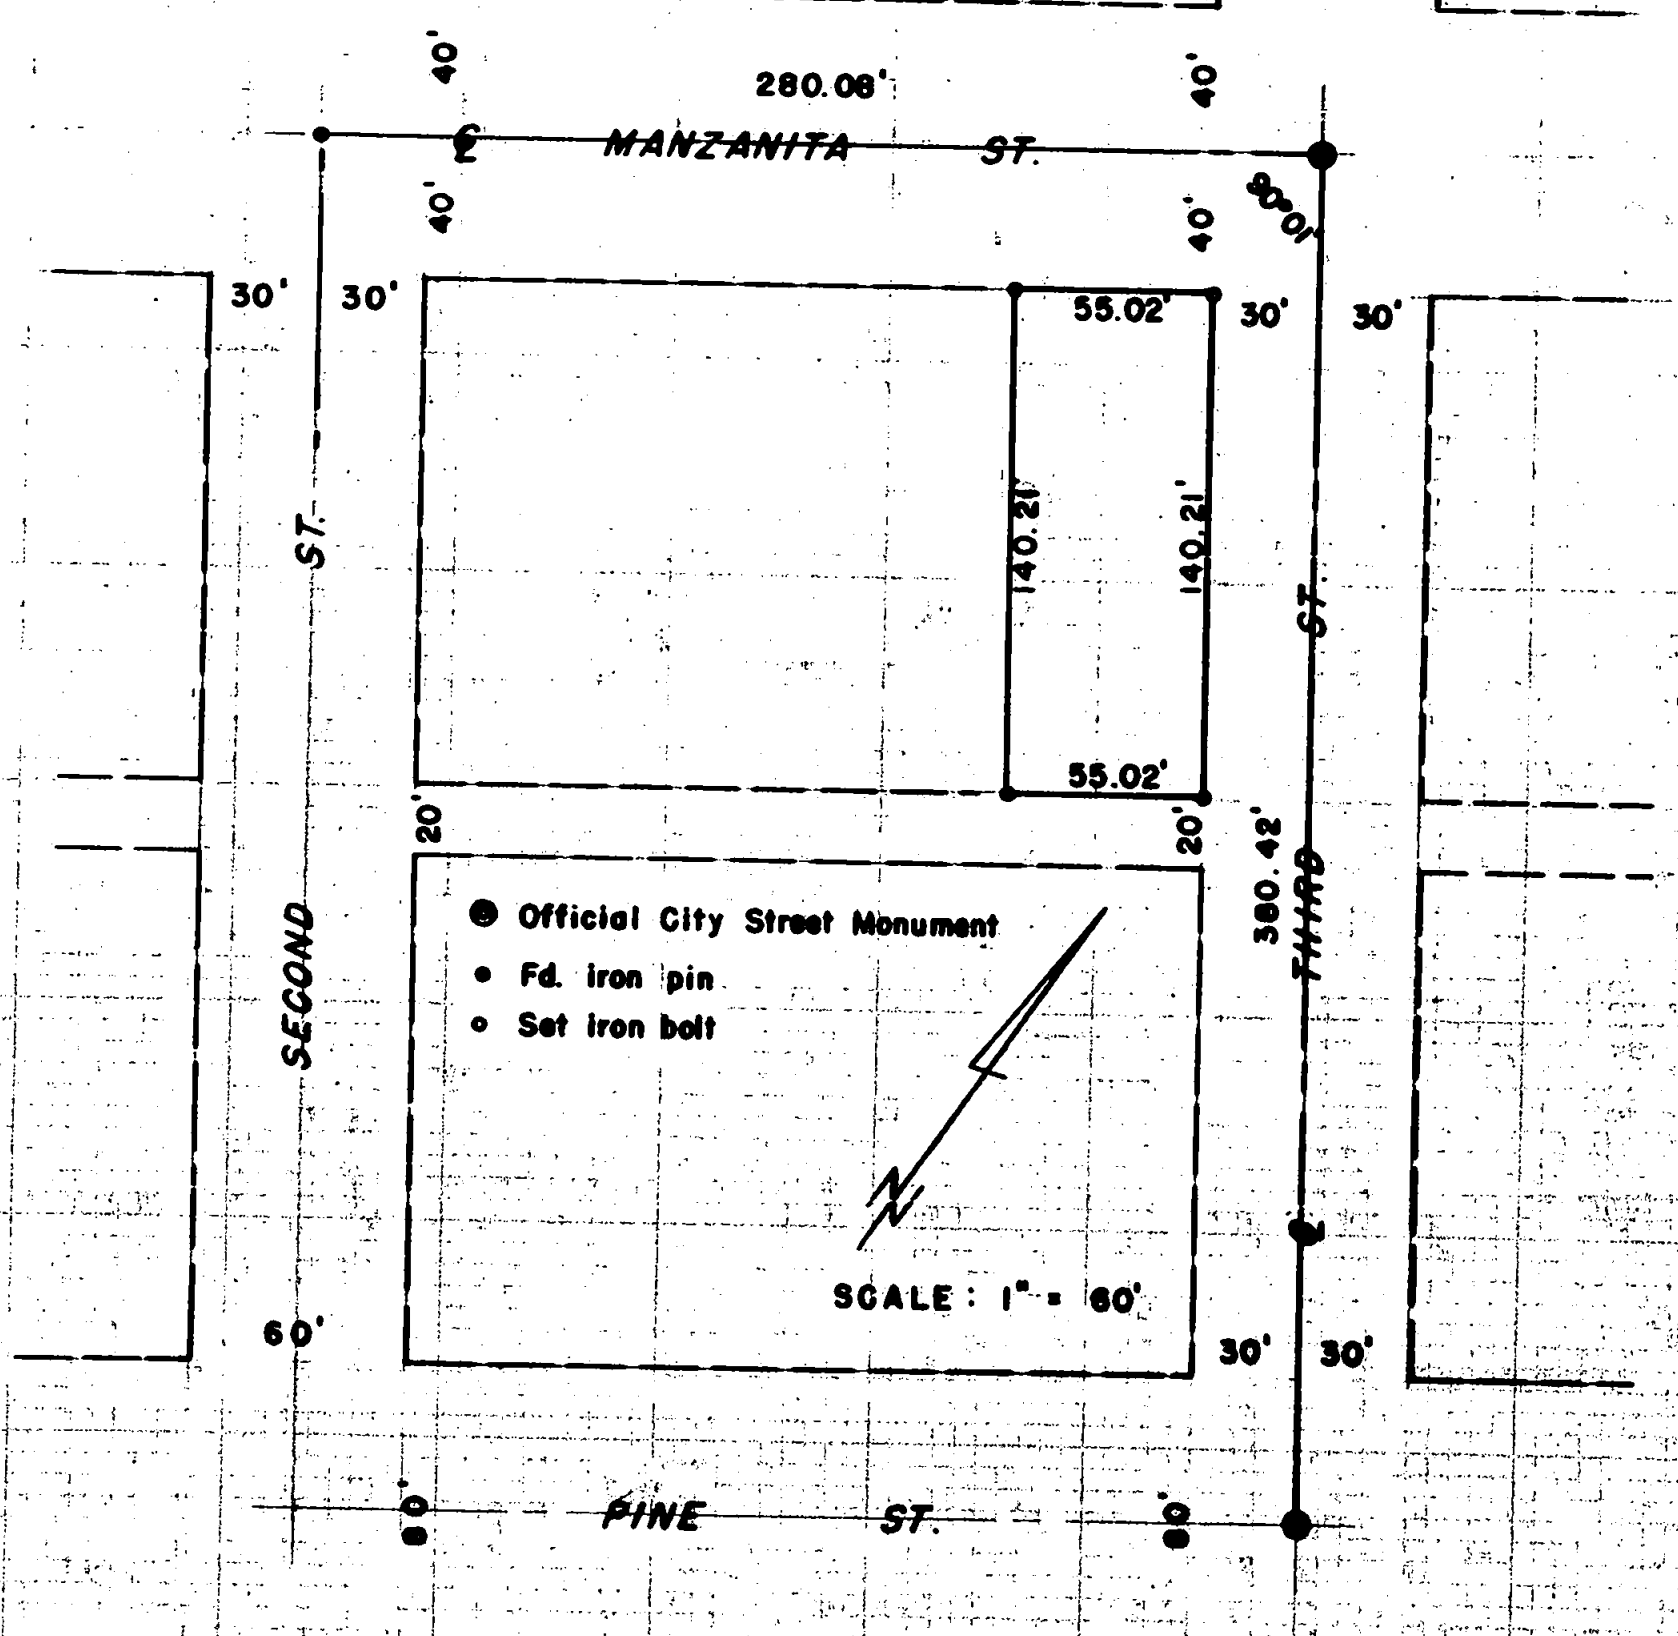

REGISTERED
OREGON
 LAND SURVEYOR
Mark E. Boyden
 NOVEMBER 9 1951
MARK E. BOYDEN
 201

RECEIVED
 JACKSON
 MAY 20 1957
 COUNTY
 ENGINEER-SURVEYOR

Survey Narrative to Comply with Paragraph 209.250,
Oregon Revised Statutes

FOR: Tom Vella

PURPOSE: To monument Lots 1 and 2, Block 6 of the Original Town
(now City) of Central Point, Oregon.

PROCEDURE: Found street centers as shown, remeasuring the distances
on Manzanita and Third Streets and the interior angle between said
streets.

Checked the pipe set at the Northwesterly corner of
recorded Survey No. 374 and then proceeded to monument the parcel
as shown.

April 1957

