


1/4 cor. Secs. 19 & 20

Survey For
BUD HOOVER
Located in Sec. 20, T36SRIW
By: M.E. Boyden
Apr. 1957

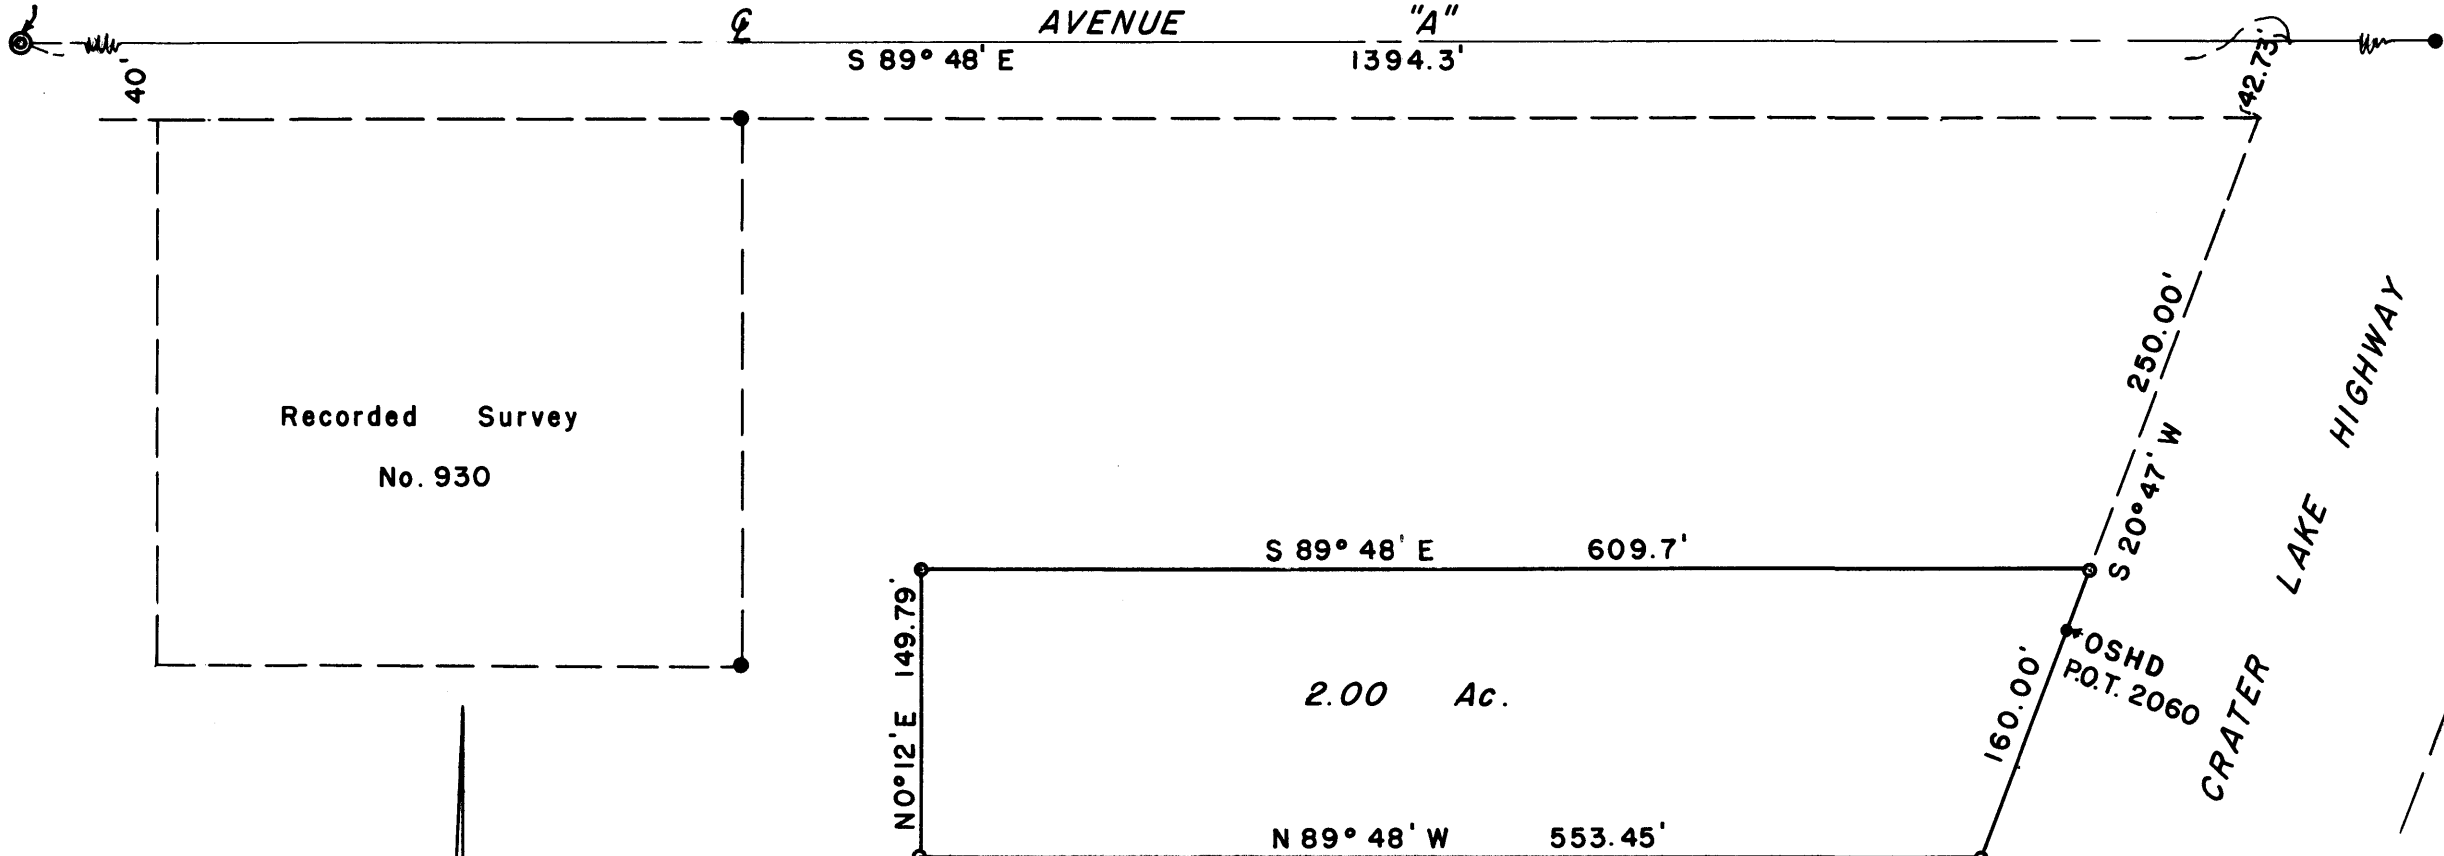

Recorded Survey
No. 930

2.00 Ac.



SCALE : 1" = 100'

- Fd. iron pin or bolt
- Set 3/4" iron bolt

M. E. BOYDEN
 LAND SURVEYOR
 1951
 M. E. BOYDEN
 1951

OSHD-2
P.O.T. 2075

OSHD
P.O.T. 2060

CRATER LAKE HIGHWAY

AVENUE "A"
S 89° 48' E 1394.3'

N0°12'E 149.79'
 S 89° 48' E 609.7'
 S 20° 47' W 250.00'
 N 89° 48' W 553.45'
 42.73'

Survey Narrative to Comply with Paragraph 209.250,
Oregon Revised Statutes

FOR: Bud Hoover

PURPOSE: To monument and describe a 2.00 acre parcel fronting
the Crater Lake Highway as directed, being located in
Section 20, Township 36 South, Range 1 West.

PROCEDURE: From points found as set on Survey No. 930, extended
the centerline of Avenue "A" easterly to intersect the Northwesterly
right-of-way line of the Crater Lake Highway. Then monumented the
parcel as shown.

April 1957

