

84-10351

10:43

4
2

10001

SPRING STREET ESTATES - UNIT NO. 3

N.E. 1/4 SECTION 20, T.37 S., R.1 W., W.M.

CITY OF MEDFORD

JACKSON COUNTY, OREGON

POST MONUMENTATION PLAT

I, Verlyn Thomas, a duly Registered Land Surveyor of the State of Oregon, do hereby certify that this map represents a survey made by me or under my direction and the monuments conform to O.R. S. 92.060.

Examined and approved this 22nd day of JUNE, 1984.


Edwin M. Deak
City Surveyor

Filed for record this 27 day of June, 1984, at 10:43 O'Clock A.m. and recorded in the Official Records of Jackson County, Oregon.

Kathleen S. Beckett
County Clerk

Mark Baker
Deputy

- Monument Found
- ⊙ Street Monument w/B. Disc Set

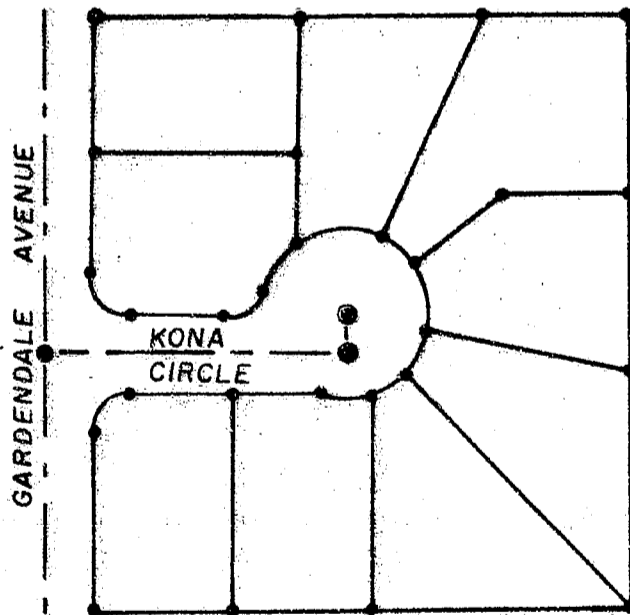

10001

REGISTERED
PROFESSIONAL
LAND SURVEYOR

Verlyn Thomas
OREGON
MAY 13, 1980
VERLYN D. THOMAS
SOS

** RECEIVED **
 Date 7/3/84 By DK
 This survey consists of:
1 sheet(s) Map
0 page(s) Narrative
 JACKSON COUNTY
 SURVEYOR