

Survey For

W. S. COCHRAN

Lots 4 & 5, Block 14


Original Town of

Medford, Oregon

By: Mark E. Boyden

Apr. 1957

1002  
1002

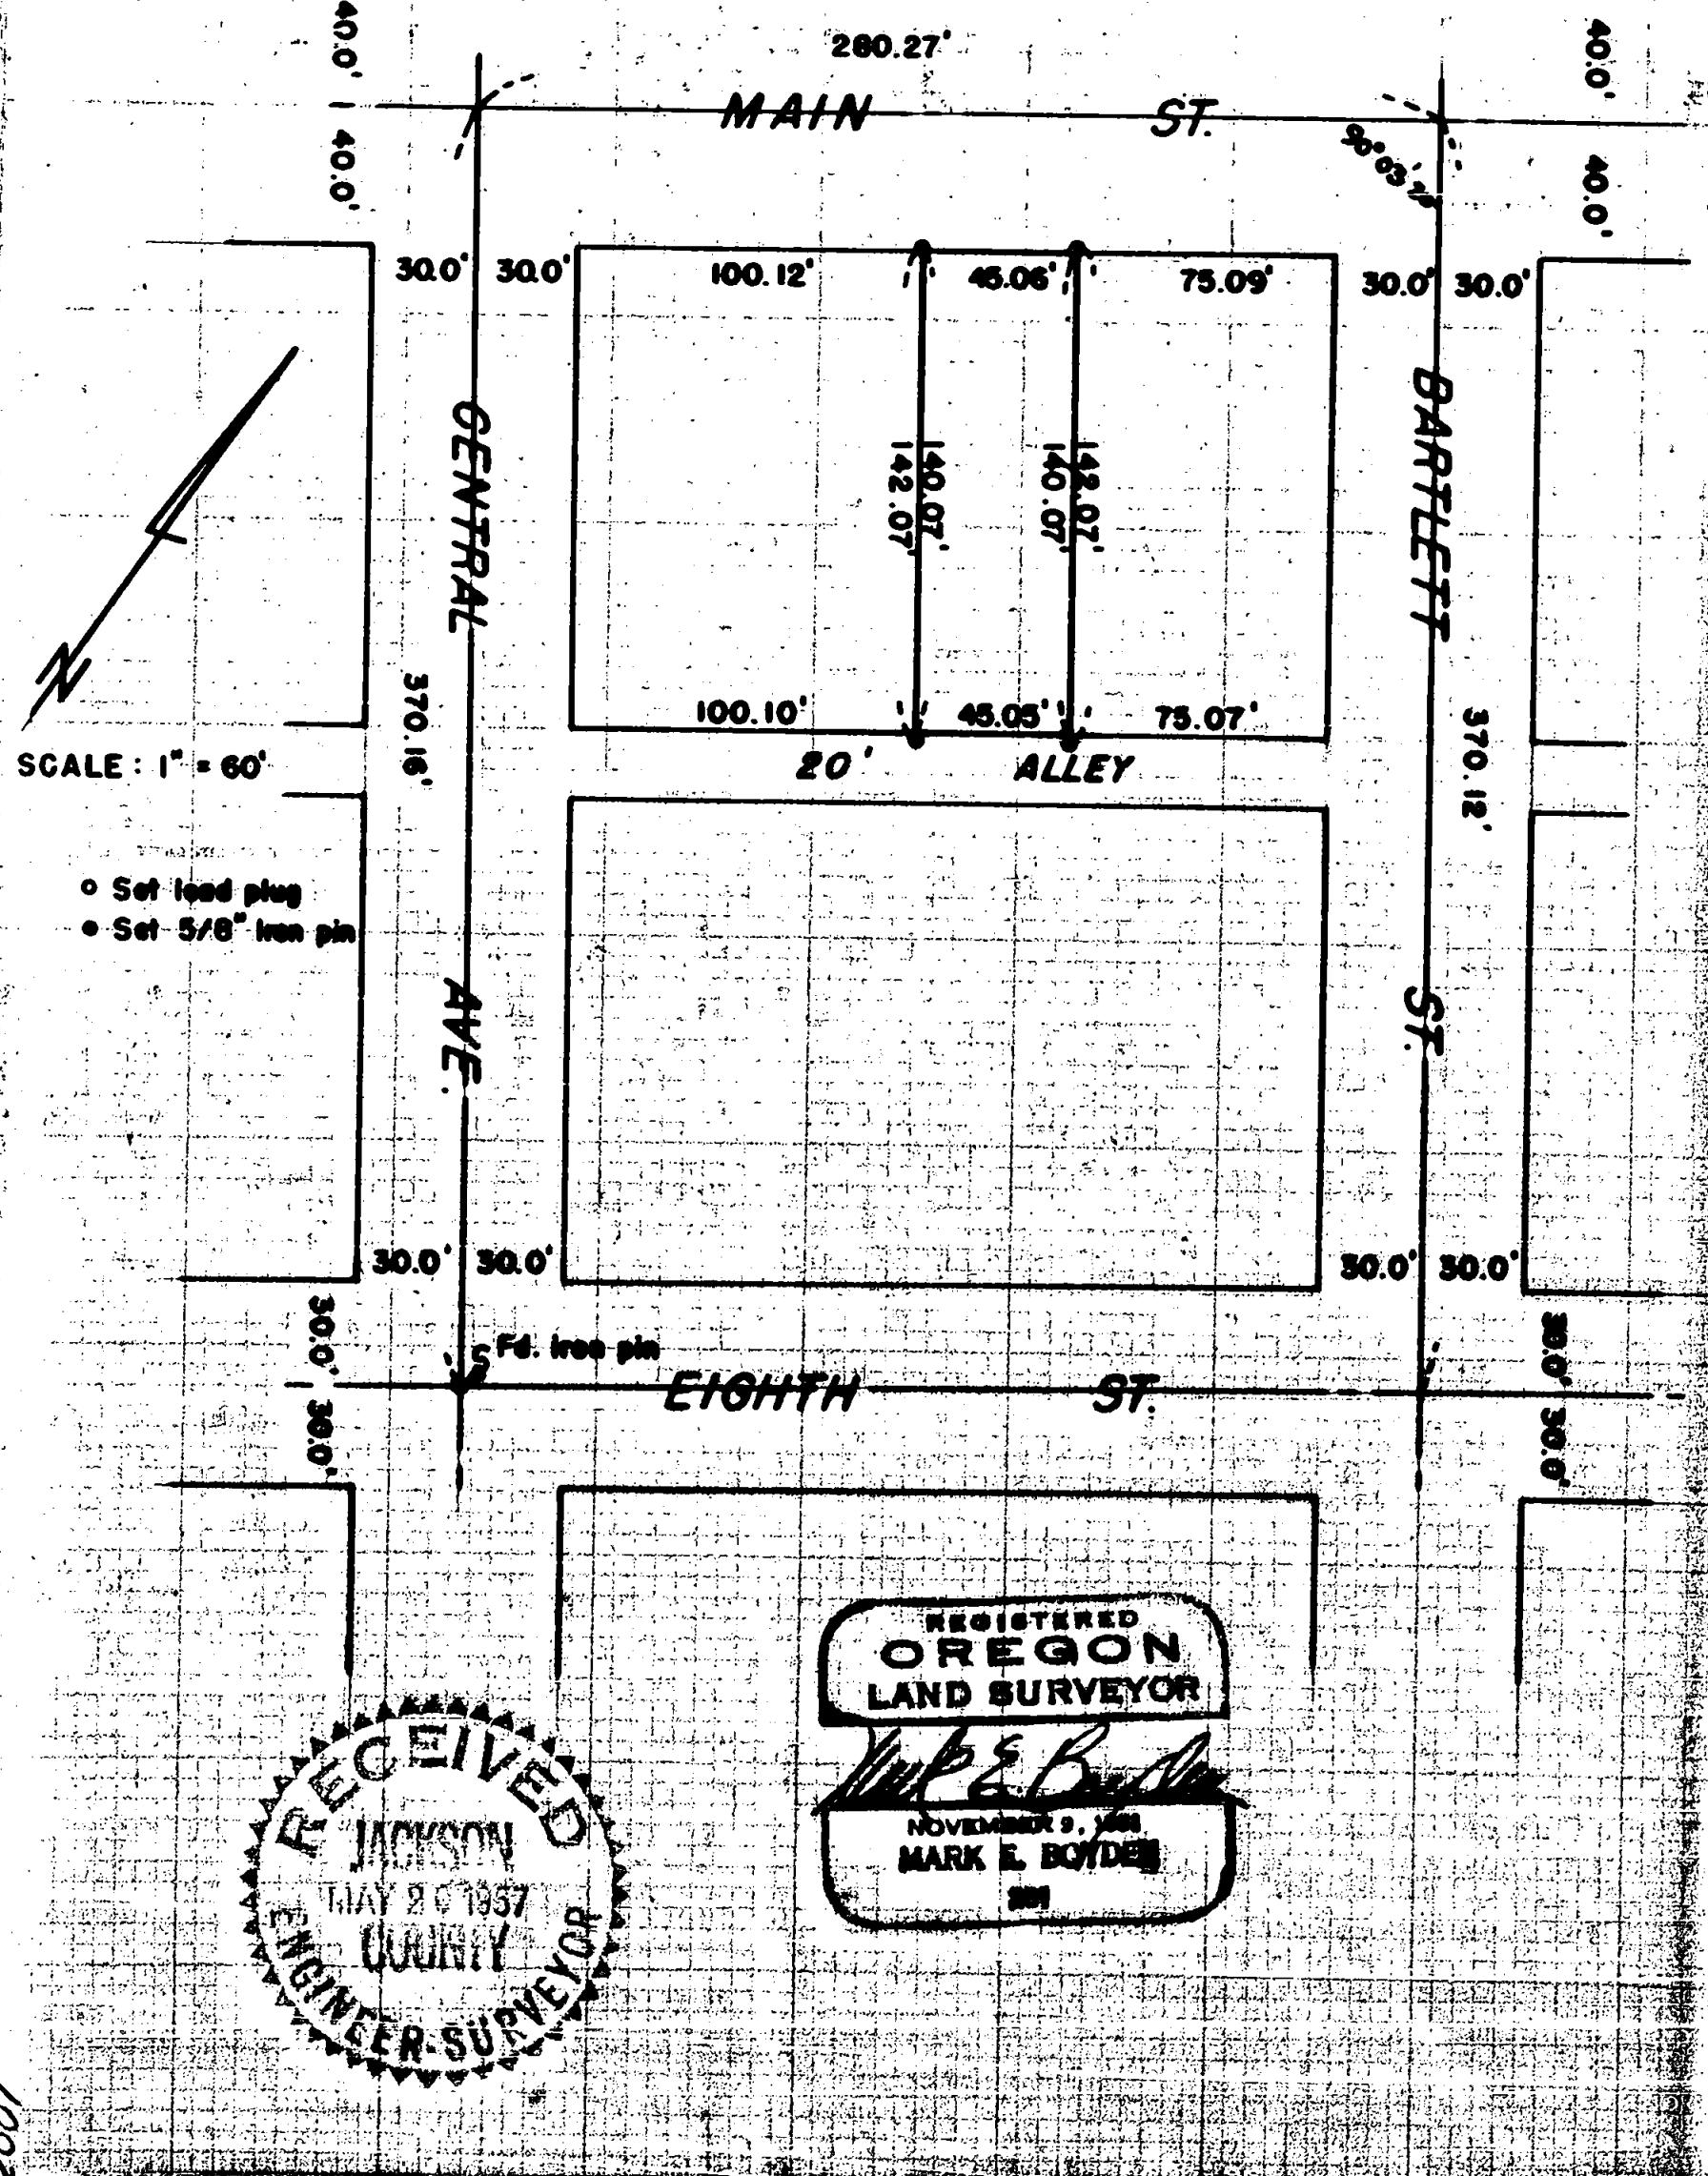

Survey Narrative to Comply with Paragraph 209.250,  
Oregon Revised Statutes

FOR: W. S. Cochran

PURPOSE: To monument the outside boundary of Lots 4 and 5, Block  
14 of the Original Town of Medford, Oregon.

PROCEDURE: Used the referenced street center at Main and Central  
and the iron pin at Eighth and Central as established Street  
controls used on Survey No. 716. Bartlett Street control was  
previously established by this office from Ninth to Fourth Streets  
with the intervening streets referenced.

From these controls, enclosed three sides of the Block  
as shown, running a check line through the alley and then propor-  
tioned the property as shown.

All corners were witnessed 1.00' offset into the street  
or alley on a projection of the Lot lines as shown.

April 1957

