

SURVEY PLAT AND NARRATIVE TO COMPLY WITH PARAGRAPH
209.250, OREGON REVISED STATUTES

Survey for: Lance Knauss
2175 Humbug Creek Road
Jacksonville, Ore. 97530

Survey by: Charles H. Hurst
765 Sunrise Ave.
Medford, Ore. 97504


Bearings : Based on Survey No. 3606

Purpose : To monument a portion of the north line of O.R. 78-05078.

Procedure

Reference is made to Survey No. 6616 and the line between quarter corners shown. Said line is for descriptive purposes only and is not intended to necessarily coincide with the North-South centerline of Sections 11 and 14. Survey control was utilized from random points established during the course of Survey No. 8213.

SURVEY SITUATE IN THE SW 1/4 SE 1/4 of SEC. 11,
T. 38 S., R. 4 W., W.M., JACKSON COUNTY, OREGON

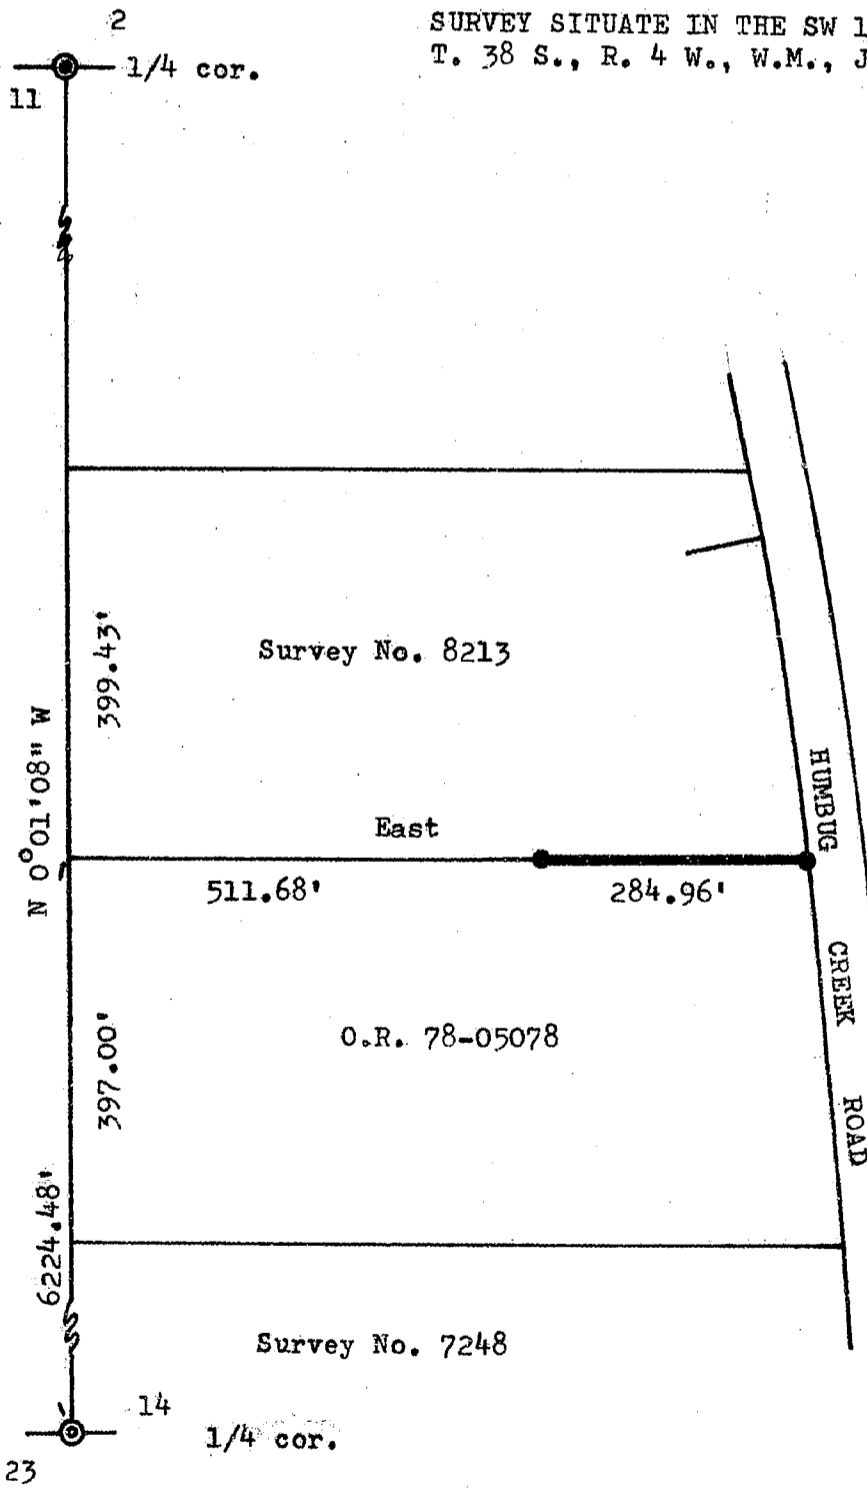

SCALE: 1" = 200'

LEGEND

● Set 5/8" x 24" iron pins

REGISTERED
PROFESSIONAL
LAND SURVEYOR

Charles H. Hurst

OREGON
OCTOBER 30, 1959
CHARLES H. HURST
483

9-25-84

** RECEIVED **
Date 9/24/84 By Bysk
This survey consists of:
1 sheet(s) Map
0 para(s) Narrative
JACKSON COUNTY
SURVEYOR

10060

10060