


10081

1/4 COR., FD. B.L.M. 1972 BR.  
CAP ON 2" G.I. PIPE, STONE, 2 B.T.'S

1/4 COR., FD. B.L.M. 1972 BR.  
CAP ON 2" G.I. PIPE, 2 B.T.'S

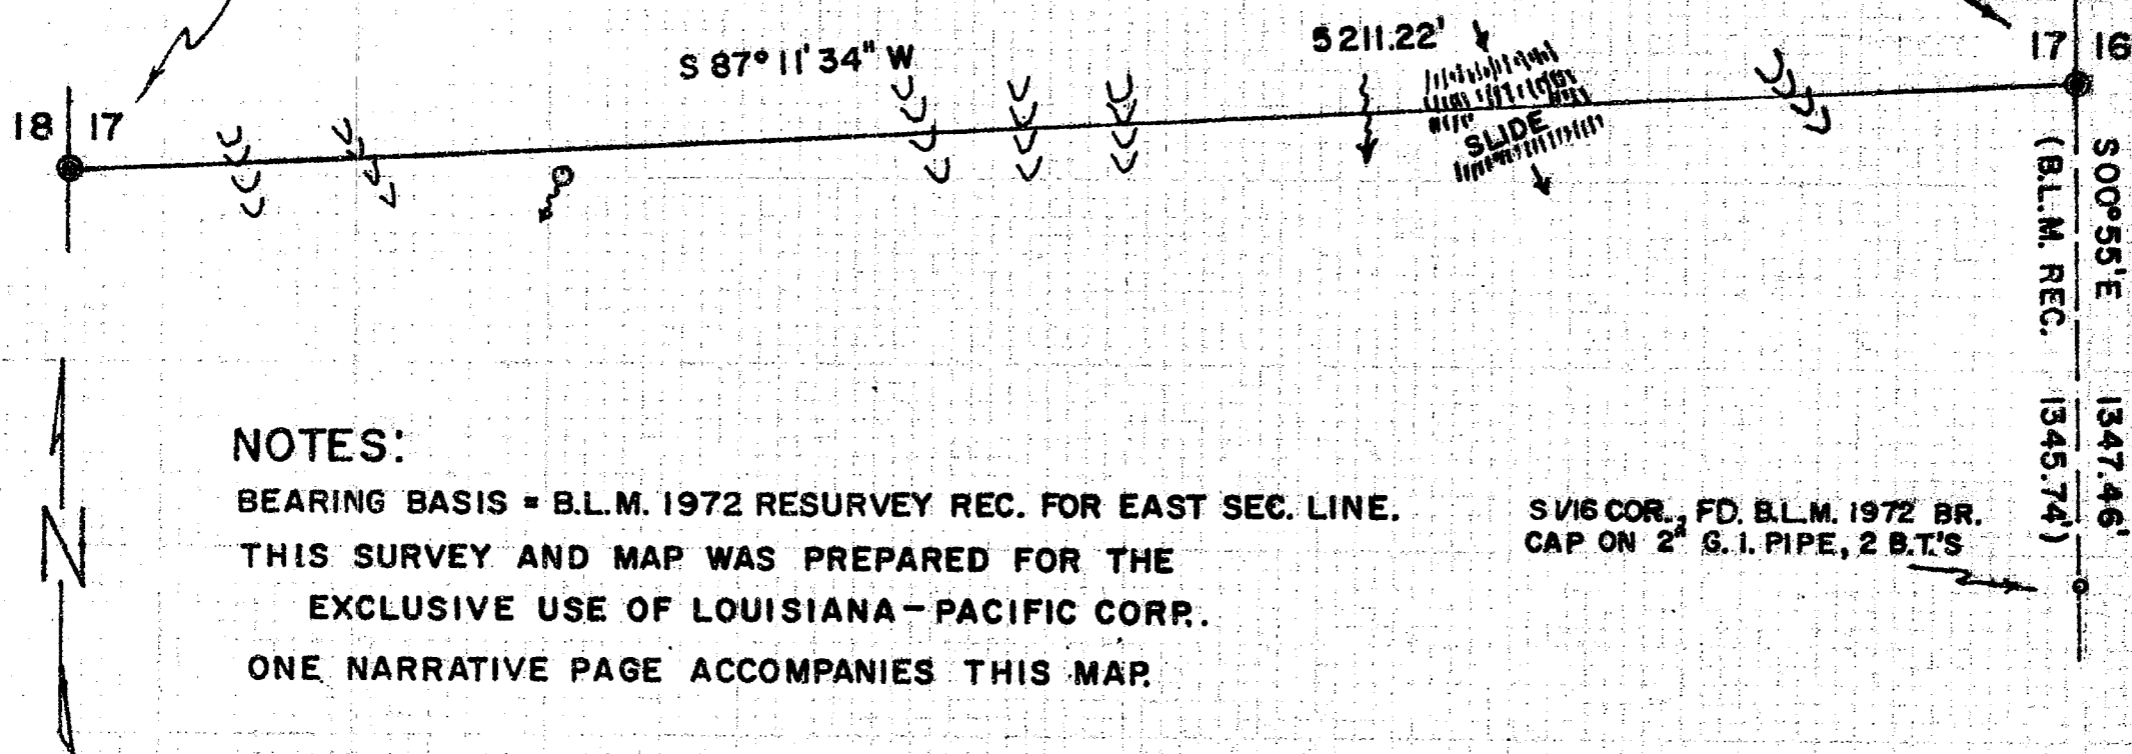

**NOTES:**

BEARING BASIS = B.L.M. 1972 RESURVEY REC. FOR EAST SEC. LINE.

THIS SURVEY AND MAP WAS PREPARED FOR THE  
EXCLUSIVE USE OF LOUISIANA-PACIFIC CORP.

ONE NARRATIVE PAGE ACCOMPANIES THIS MAP.

S 1/8 COR., FD. B.L.M. 1972 BR.  
CAP ON 2" G.I. PIPE, 2 B.T.'S

\*\* RECEIVED \*\*

Date 10/10/84 By sk

This survey Consists of:

1 sheet(s) Map

1 page(s) Narrative

JACKSON COUNTY  
SURVEYOR

**SURVEY TO LOCATE & MARK THE E-W CENTER LINE  
OF SECTION 17, T 38S, R 2E, W. M., JACKSON CO., OREGON**

SCALE: 1 INCH = 500 FEET.

SEPTEMBER 17, 1984.

ROBT. M. THOMPSON & ASSOC.

REGISTERED  
PROFESSIONAL  
LAND SURVEYOR

*Robert M. Thompson*

OREGON  
SEPTEMBER 23, 1977  
ROBERT M. THOMPSON  
1358

38 2E 17 10081

SURVEY TO LOCATE AND MARK THE E-W CENTER LINE  
OF SECTION 17, T38S, R2E, W.M.  
JACKSON COUNTY, OREGON

Narrative Description to comply with Par. 209-250, O.R.S.  
(Note, 1 map sheet accompanies this narrative)

FOR: Louisiana Pacific Corp., P.O. Box 711, Lakeview, OR 97630

BY: Robt. M. Thompson & Assoc., 1140 Acacia Lane, Grants Pass, OR 97527

PURPOSE: As stated above.

PROCEDURE: After traversing between the B.L.M. established East  $\frac{1}{4}$  corner and South  $\frac{1}{16}$  corner for Sections 17 & 16, the East-West Center Line of Section 17 was surveyed and the true line was marked with blazes and red flagging. Bearing basis was taken from the B.L.M. record for the East line of Section 17. Corners were found as follows:

$\frac{1}{4}$  Corner for Sections 18 & 17, found B.L.M. 1972 brass cap on 2" G.I. Pipe, original stone alongside, and B.T.'s:  
38" Fir N 7°E 56.4', healed faces (O.B.T.)  
28" Fir N 7 $\frac{1}{2}$ °W 89.8', healed faces (O.B.T.)

$\frac{1}{4}$  Corner for Sections 17 & 16, found B.L.M. 1972 brass cap on 2" G.I. Pipe, and 1972 B.T.'s:  
29" Fir S 43°E 26.7', healed  
14" W. Fir S 80°W 27.7', healed

South  $\frac{1}{16}$  Corner for Sections 17 & 16, found B.L.M. 1972 brass cap on 2" G.I. Pipe, and 1972 B.T.'s:  
30" I. Cedar S 72 $\frac{1}{2}$ °E 46.9', scribe part vis.  
29" Fir N 55 $\frac{1}{2}$ °W 70.0', healed

September 17, 1984

