

SURVEY OF PORTION OF R.G. WAITE AND W.I. WHIPPLE PROPERTIES

LOCATED IN
NW 1/4, SECTION 30
T. 36 S., R. 4 W., WM.

SCALE: 1"=300'

MAY 15, 1957



1/4 CORNER 19 1/2 30

FD. 2" I.P.
FD. 14" ALDER 55 1/2" E
6.6 FT. SCRIBE VISIBLE.
A S.H.B.M. MONUMENT
BEARS S54°W 93.7H.
IN NE COR. BRIDGE ABT.

1000.0

Set 1/4" I.P. AND "RE3024"

S89°50'W
321.6

V. 373
P. 46 WHIPPLE

Set 1/2" I.P. AND "RE3024"

N. 09° 23' W

RES.

FD. 5/8" I. Rod
set 3-11-52

V. 321
P. 203 WAITE

Savage Creek


528.0

FD. 5/8" I. Rod
set 3-11-52

527.0

321.6
N89°50'W

CENTER SEC. 30
FD. 7/8" I. Rod IN
Boulder SET BY
BOYDEN, Co. SURV.

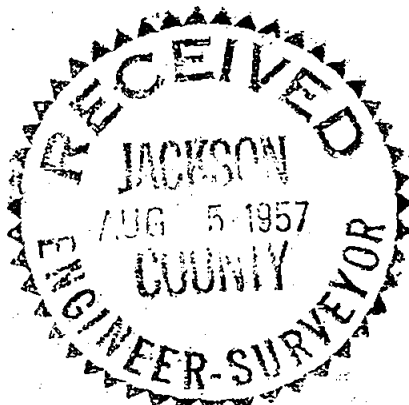

NOTE:
Bearings are referred to record bearing
of north and south centerline of section.
Survey executed with Leupold Mtn. transit
and 200 ft. steel tape. This survey dependent
upon survey executed March 11, 1952. Error
of closure 1/10000.

