

84-19086

- 1 - 10123

10:41

400
200


Survey Fee 5000

STATE OF OREGON)
County of Jackson) ss

AFFIDAVIT OF CORRECTION

I, Robert Joseph Milts, a duly Registered Professional Land Surveyor of the State of Oregon, being first duly sworn, do hereby depose and state that I surveyed the subdivision known as Cascade Village Unit No. 10 - Phase 3, as recorded in Volume 15 of plats on page 12 of records in Jackson County, Oregon and also filed in the Jackson County Surveyor's office as Survey No. 9783, and that the following correction is required, to-wit:

Set witness corner 5 feet east of true corner on line between Lots 25 and 26, Block 20.

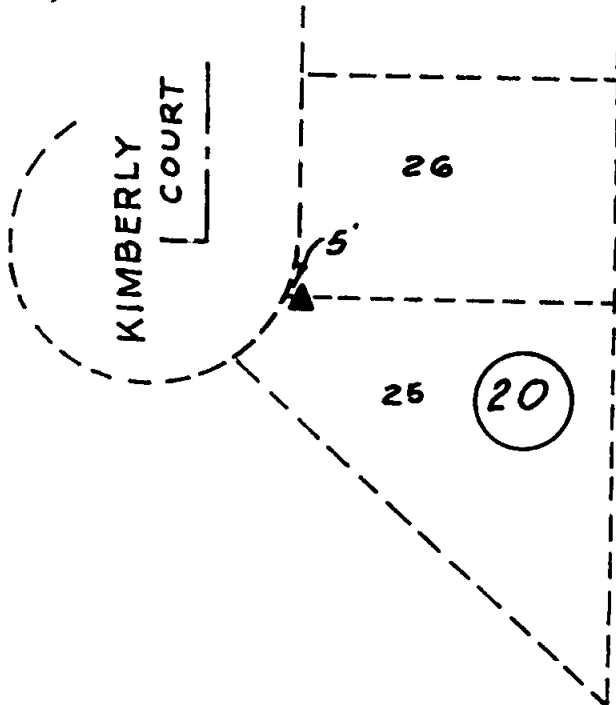

4
1" = 60'

REGISTERED
PROFESSIONAL
LAND SURVEYOR

Robert Joseph Milts

OREGON
SEPTEMBER 23, 1977
ROBERT JOSEPH MILTS
No. 1270

Owner: Jackson County Land & Development Co.

Charles A. Strom
CHARLES A. STROM
NOTARY PUBLIC - OREGON
MY COMMISSION EXPIRES MAY 3, 1988

Robert Joseph Milts
Registered Professional Land Surveyor #1270
Marquess & Associates, Inc.
1120 E. Jackson Street
Medford, Oregon 97504

Subscribed and sworn to before me on this 6TH day of NOVEMBER, 1984.

Examined and approved this 13 day of November, 1984.

Edward G. McCarty
Jackson County Surveyor

Jackson County, Oregon
Recorded
OFFICIAL RECORDS

10:41 NOV 27 1984 A.M.

KATHLEEN S. BECKETT
CLERK and RECORDER
Ruby A. Soling Deputy

84-19086

- 1 - 10123

10:41

400
200


Survey Fee 5000

STATE OF OREGON)
)ss
County of Jackson)

AFFIDAVIT OF CORRECTION

I, Robert Joseph Milts, a duly Registered Professional Land Surveyor of the State of Oregon, being first duly sworn, do hereby depose and state that I surveyed the subdivision known as Cascade Village Unit No. 10 - Phase 3, as recorded in Volume 15 of plats on page 12 of records in Jackson County, Oregon and also filed in the Jackson County Surveyor's office as Survey No. 9783, and that the following correction is required, to-wit:

Set witness corner 5 feet east of true corner on line between Lots 25 and 26, Block 20.

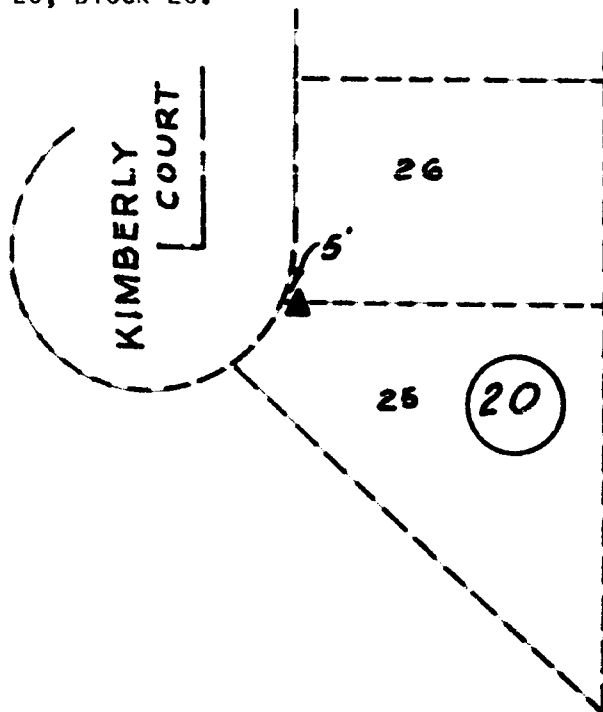

A
1" = 60'

REGISTERED
PROFESSIONAL
LAND SURVEYOR

Robert Joseph Milts

OREGON
SEPTEMBER 23, 1977
ROBERT JOSEPH MILTS
No. 1270

Owner: Jackson County Land
& Development Co.

Charles A. Strom
CHARLES A. STROM
NOTARY PUBLIC - OREGON
MY COMMISSION EXPIRES MAY 3, 1988

Robert Joseph Milts
Registered Professional Land Surveyor #1270
Marquess & Associates, Inc.
1120 E. Jackson Street
Medford, Oregon 97504

Subscribed and sworn to before me on this 6TH day of
NOVEMBER, 1984.

Examined and approved this 13 day of November, 1984.

Edward G. McCarty
Jackson County Surveyor

Jackson County, Oregon
Recorded
OFFICIAL RECORDS

10:41 NOV 27 1984 A.M.

KATHLEEN S. BECKETT
CLERK and RECORDER

Richard A. ...
Deputy