


10139

10139

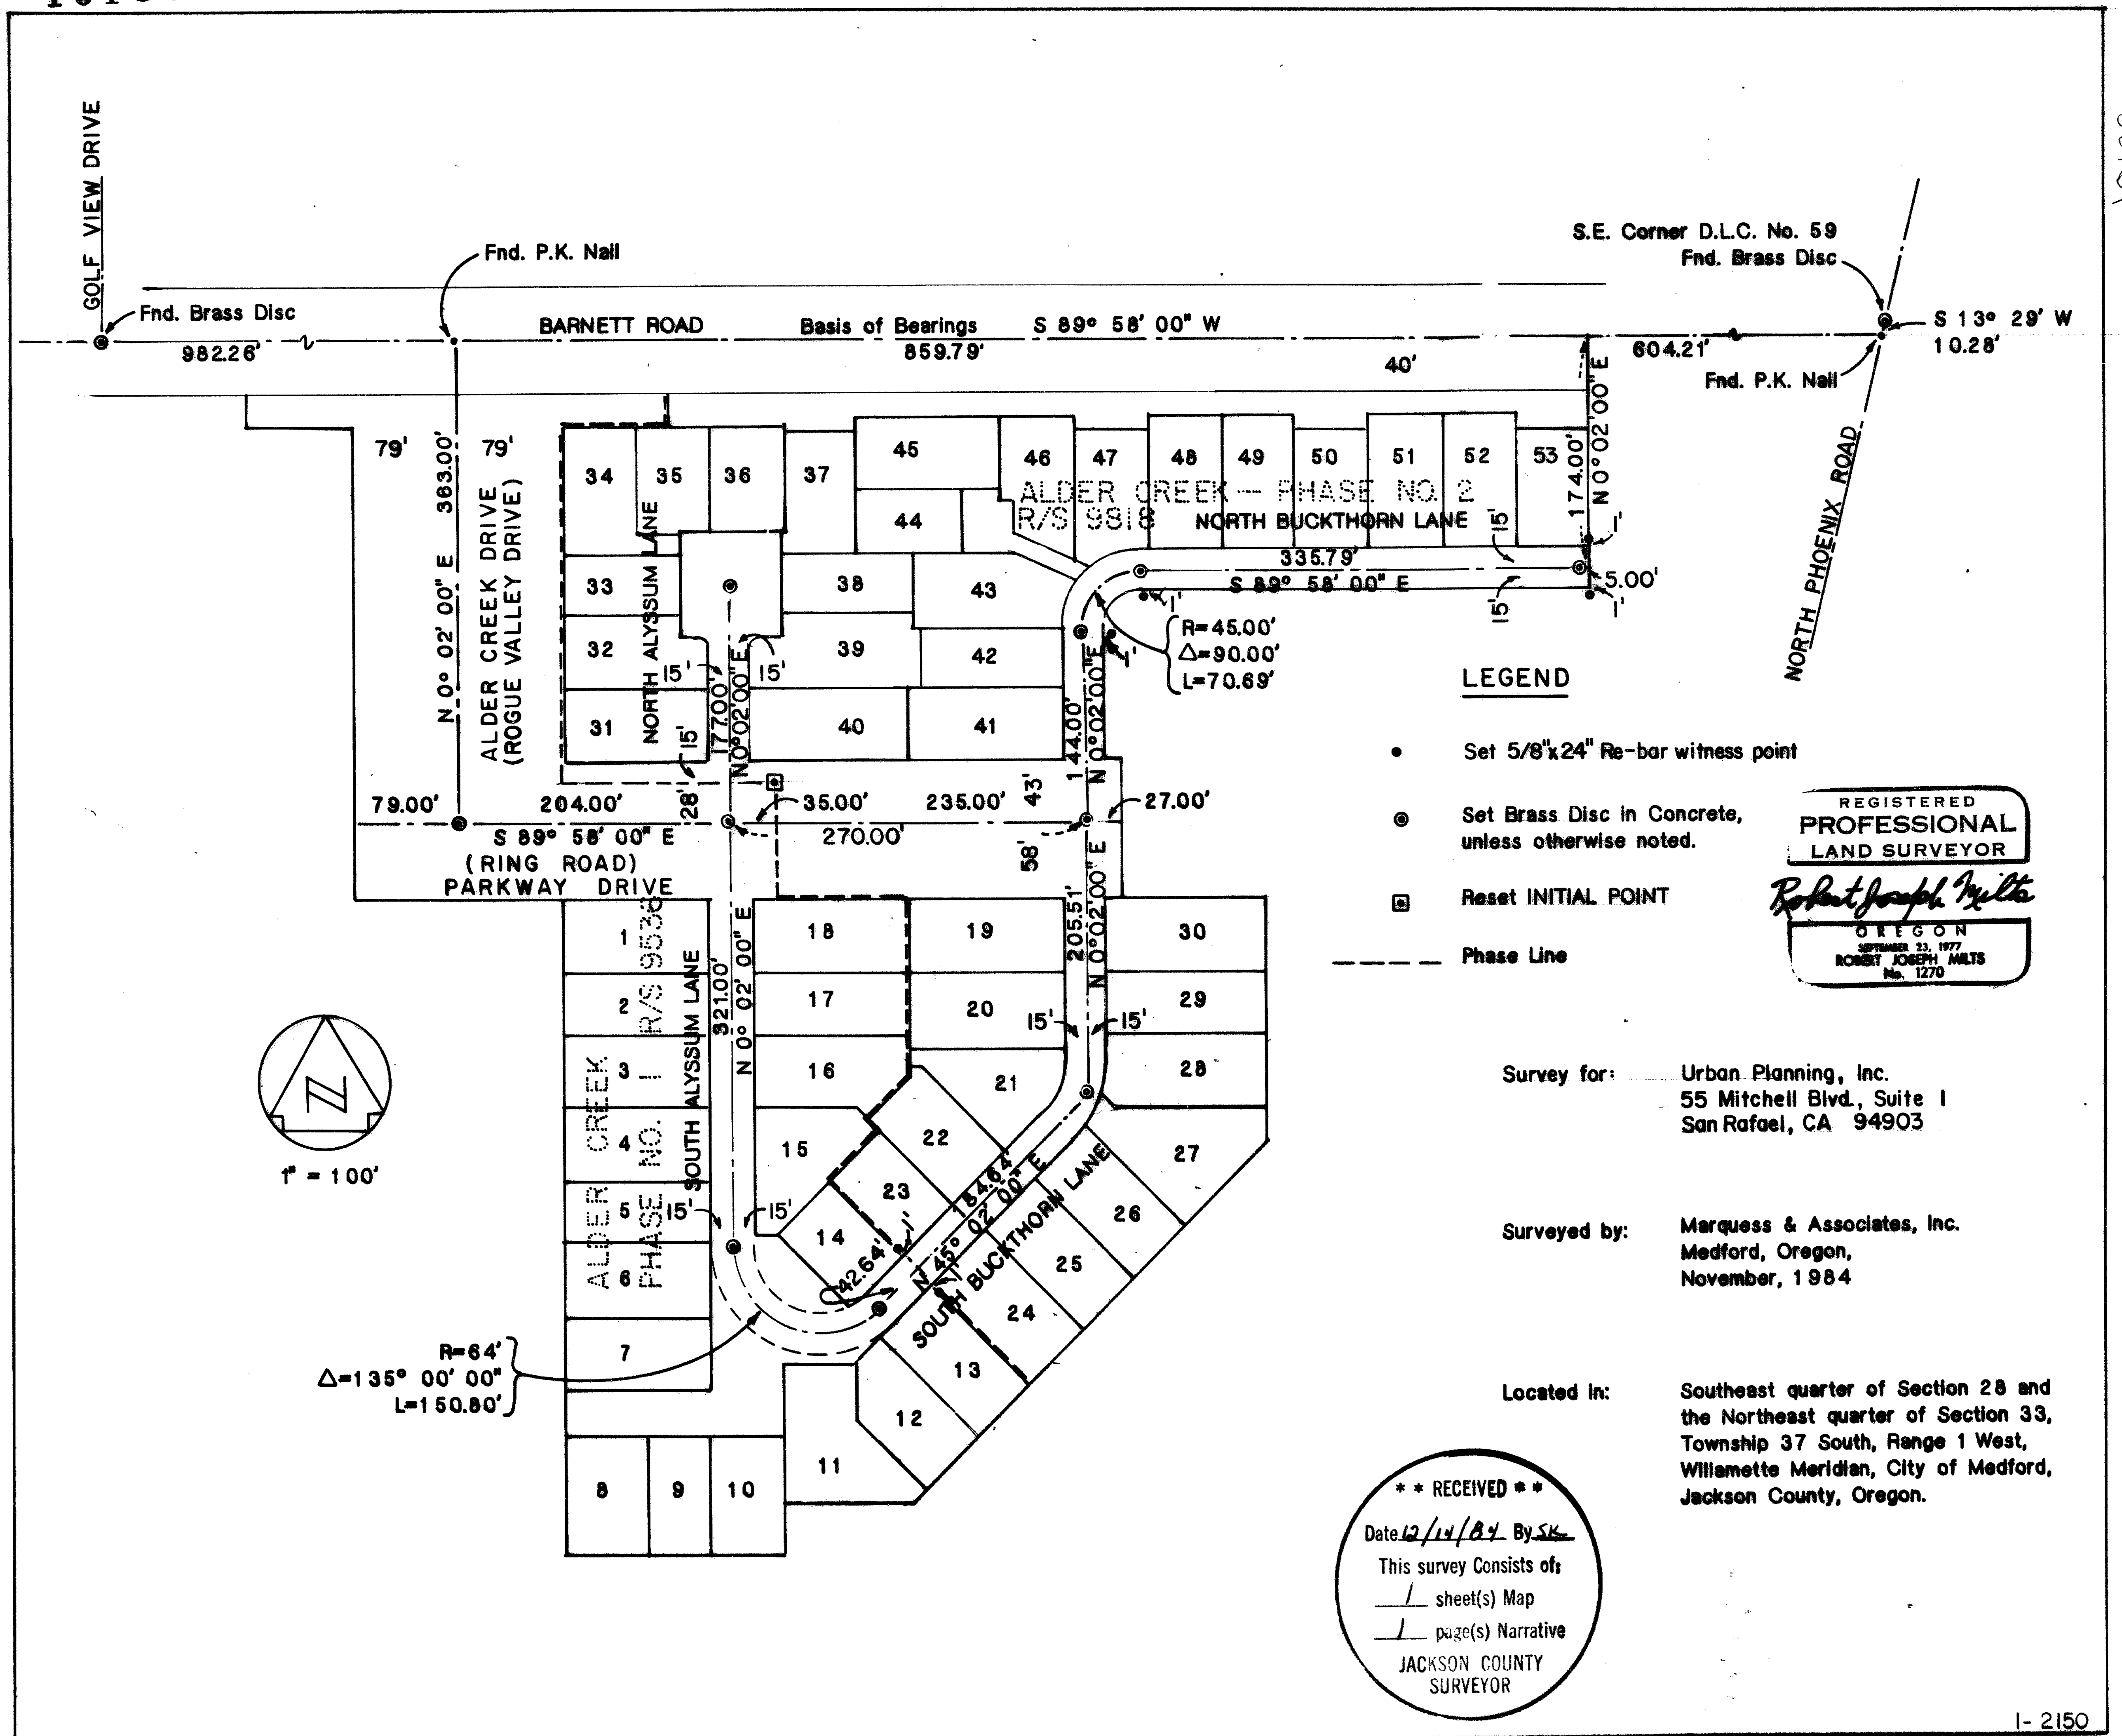

LEGEND

- Set 5/8"x24" Re-bar witness point
- ⊙ Set Brass Disc in Concrete, unless otherwise noted.
- ⊠ Reset INITIAL POINT
- Phase Line


REGISTERED
PROFESSIONAL
 LAND SURVEYOR
Robert Joseph Maltz
 OREGON
 SEPTEMBER 23, 1977
 ROBERT JOSEPH MALTS
 No. 1270

Survey for: Urban Planning, Inc.
 55 Mitchell Blvd., Suite 1
 San Rafael, CA 94903

Surveyed by: Marquess & Associates, Inc.
 Medford, Oregon,
 November, 1984

Located in: Southeast quarter of Section 28 and
 the Northeast quarter of Section 33,
 Township 37 South, Range 1 West,
 Willamette Meridian, City of Medford,
 Jackson County, Oregon.

**** RECEIVED ****
 Date 12/14/84 By SK
 This survey consists of
1 sheet(s) Map
1 page(s) Narrative
 JACKSON COUNTY
 SURVEYOR

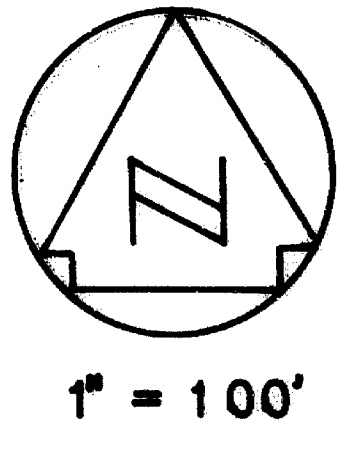

R=64'
 $\Delta=135^\circ 00' 00''$
 L=150.80'

I-2150

37 1W 33 RA 10139

SURVEY NARRATIVE TO COMPLY WITH PARAGRAPH 209.250
OREGON REVISED STATUTES

SURVEY FOR: Urban Planning, Inc.
55 Mitchell Blvd., Suite 1
San Rafael, California 94903

LOCATION: Southeast quarter of Section 28 and the Northeast quarter of
Section 33, Township 37 South, Range 1 West, Willamette
Meridian, City of Medford, Jackson County, Oregon.

PURPOSE: To construct survey monuments along centerline of streets
within the Alder Creek development, Phases 1 and 2; reset
witness corners destroyed during construction.

PROCEDURE: Using the relocated centerline of Barnett Road, which was
established from the found centerline monuments shown, the
centerline monuments of the streets were surveyed. The
initial point, which was disturbed during construction of
streets and lots, was re-set. The survey work was performed
with a 20 second theodolite and an electronic measuring device.

REGISTERED
PROFESSIONAL
LAND SURVEYOR

Robert Joseph Milts

OREGON
SEPTEMBER 23, 1977
ROBERT JOSEPH MILTS
No. 1270

MARQUSS & ASSOCIATES, INC.
1120 E. Jackson Street
P. O. Box 490
Medford, Oregon 97501

Robert Joseph Milts

Robert Joseph Milts, P. E.
Professional Land Surveyor

** RECEIVED **
Date 12/14/84 By SK
This survey Consists of:
1 sheet(s) Map
1 page(s) Narrative
JACKSON COUNTY
SURVEYOR