

10156

Fd. man. spike of First Street
S 54° 52' 30" W (see S/N 9320)

LAUREL STREET

40.00'

STREET

Fd. 1/2" iron pin

meas. 55.28'

30.00'

SURVEY NO. 443

N 35° 12' 41" W

meas. 90.40'

S 54° 52' 30" W

meas. 55.20'

N 35° 09' 30" W

meas. 90.40'

meas. 50.00'

meas. 50.00'

Fd. 1/2" iron pin

meas. 55.15'

S 54° 52' 30" W

meas. 110.40'

Fd. 3/4" iron pin (no cap)

Fd. 3/4" iron pin, bent (set spike in correct position)

SURVEY NO. 9320

N 35° 09' 30" W

meas. 70.40'

SECOND STREET

Fd. 3/4" iron pin w/red "Boyd" cap

meas. 30.00'

Fd. spike at Manzanita St.

MAP OF SURVEY
LOCATED IN
Lots 1 & 2, Block 12
of the
ORIGINAL TOWN OF CENTRAL POINT
(37 2W 3DD-5800 & 5900)
JACKSON COUNTY, OREGON
FOR
JACKSON COUNTY FEDERAL SAVINGS & LOAN ASSOC.

HOFFBUHR/BATH & ASSOCIATES, INC.
219 N. OAKDALE MEDFORD, OREGON

BY: RICHARD L. BATH R.P.L.S. NO. 1069
SCALE: 1"=50' OCTOBER 22, 1984
BASIS OF BEARING S/N 9320

● = Set 5/8" x 24" iron pin w/plastic cap marked "R. BATH L.S. 1069"

S/N= Survey No.

REGISTERED
PROFESSIONAL
LAND SURVEYOR

Richard L. Bath

OREGON
JULY 30, 1974
RICHARD L BATH
No. 1069

** RECEIVED **
Date 12/19/84 By SK
This survey Consists of:
— 1 sheet(s) Map
— 1 page(s) Narrative
JACKSON COUNTY
SURVEYOR

10156

37 211 322

SURVEY NO. 10156

SURVEY NARRATIVE TO COMPLY WITH PARAGRAPH 209.250
OREGON REVISED STATUTES

FOR: Jackson County Federal
Savings & Loan Assoc.
2 E. Main
Medford, Oregon 97501

LOCATION: Lots 1 and 2 in Block 12 of the Original Town of
Central Point, Oregon. (37-2W-3DD - 5800 & 5900)

PURPOSE: To survey and monument the tracts as shown on the
attached map per client's request.

PROCEDURE: Using control established by Survey No's. 443,
7672, and 9320, monumented the boundary of the
tracts as shown.


BASIS OF BEARING: Survey No. 9320

DATE: October 22, 1984

REGISTERED
PROFESSIONAL
LAND SURVEYOR

Richard L. Bath

OREGON
JULY 30, 1976
RICHARD L. BATH
No. 1069

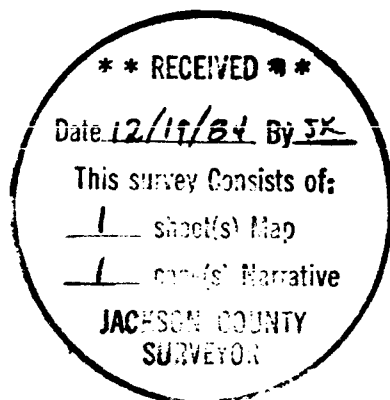

Richard L. Bath
Hoffbuhr/Bath & Assoc., Inc.
219 North Oakdale Ave.
Medford, Oregon 97501
(503) 779-4641