

10197

SURVEY FOR:

**FARWEST STEEL CORP**

LOCATED IN BLOCK 3 OF EHRMAN WAREHOUSE INDUSTRIAL DISTRICT (RECORDED)  
SE 1/4 OF SECTION 14, T.37S., R.2 W., W.M.  
JACKSON COUNTY, OREGON

FEBRUARY 25, 1985

SURVEY BY

BOYDEN SURVEYORS  
108 MISTLETOE STREET  
MEDFORD, OREGON

FOUND 3/4" I. PIPE 10" DEEP

**EHRMAN WAY**

S 89°55'05" E (REC. = S 89°55' E)

7" DEEP

FILED SURVEY No. 7770  
(FILED SURVEY No. 7770 = N 0°04'25" E 250.21'  
N 0°05'25" E (REC. N 0°05' E) 250.21'

FILED SURVEY No. 7770

FOUND 1/2" I. PIPE 10" DEEP (SW COR. BLK. 3 E.W.I.D.)

100.00' S 89°54' E

RES. FOR R.R. & UTIL.

INST. No. 85-01439 O.R.

N 89°55'05" W 302.06' (REC. = N 89°55' W, 301.96')

INST. No. 85-01440 O.R.

\*\* RECEIVED \*\*

Date 2/26/85 By SK

This survey consists of:

1 sheet(s) Map

1 page(s) Narrative

JACKSON COUNTY SURVEYOR

REGISTERED PROFESSIONAL LAND SURVEYOR

*Gary D. Kaiser*

OREGON JULY 16, 1987 GARY D. KAISER No. 803

SCALE: 1" = 60'

BASIS OF BEARINGS

FILED SURVEY No. 8186

LEGEND

⊗ FOUND MONUMENT AS INDICATED

○ FOUND 3/4" REBAR

● SET 5/8" X 24" REBAR WITH A PLASTIC CAP MARKED "KAISER R.L.S. 803"

37 2W 14 D

10197

Survey No. 10197

SURVEY NARRATIVE TO COMPLY WITH O.R.S. 209.250

SURVEY FOR: Farwest Steel Corporation  
P.O. Box 889  
Eugene, Oregon, 97440

SURVEY BY: Bovden Surveyors  
108 Mistletoe Street  
Medford, Oregon, 97501



LOCATION: Block 3 of EHRMAN WAREHOUSE INDUSTRIAL DISTRICT  
(Recorded) in the Southeast Quarter of Section  
14, Township 37 South, Range 2 West of the  
Willamette Meridian in Jackson County, Oregon .

BASIS OF BEARINGS: Filed Survey No. 8186

DATE: February 25, 1985.

PURPOSE: To monument the common boundary between tracts  
described in Instrument Nos. 85-01439 & 85-01440,  
Official Records of Jackson County, Oregon.

PROCEDURE: Utilizing a one-second theodolite and E. D. M.  
equipment, the described boundary was monumented  
from existing monumentation and the centerline  
of the Southern Pacific Company mainline tracks  
as shown on the annexed map.

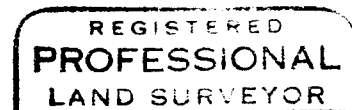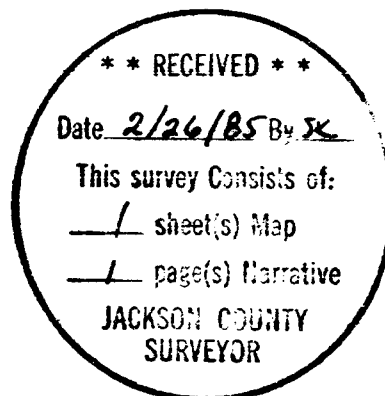

*Gary D. Kaiser*

