

10223

1/4 COR., FD. 1" G.I. PIPE W/
BR. CAP, 3 B.T.'S, B.T. STUMP.

17 16

(G.L.O. REC. NORTH 2640.0')
NORTH 2676.64'

DITCH

SURVEY TO LOCATE PORTIONS OF THE SOUTH & WEST LINES OF SEC. 16, T39S, R2W, W.M., JACKSON CO., OR.

SCALE: 1 INCH = 400 FEET

MARCH 22, 1985.

ROBT. M. THOMPSON & ASSOC.

LEGEND & NOTES: (SEE NARRATIVE FOR CORNER DETAILS.)

- ⊙ GOVT. CORNER FOUND.
 - ⊙ CORNER NOT FOUND, SET 5/8" X 30" I. ROD W/YEL. CAP.
 - TRUE LINE MARKED W/RED-PAINTED BLAZES, "P/L BCC" TAGS.
- THIS SURVEY & MAP WAS COMPLETED FOR THE EXCLUSIVE USE OF
BOISE CASCADE CORP.
- BEARING BASIS: G.L.O. RECORD FOR WEST SECTION LINE.

SEC. COR., FD. 1" G.I. PIPE
W/BR. CAP, 6 B.T.'S.

17 16

20 21

2682.38'

N 89°15'47" E
(G.L.O. REC. N 89°30' E 5340.72')

5364.76'

1/4 COR. NOT FD., SET 5/8" X 30" I. ROD
MKD. "THOMPSON", SCRIBED 2 B.T.'S.

SEC. COR., FD. 2" I. PIPE W/ BR.
CAP, 4 B.T.'S

16 15

21 22

** RECEIVED **

Date 4/1/85 By SK

This survey consists of:

1 sheet(s) Map

1 page(s) Narrative

JACKSON COUNTY
SURVEYOR

REGISTERED
PROFESSIONAL
LAND SURVEYOR

Robert M. Thompson

OREGON
SEPTEMBER 23 1977
ROBERT M. THOMPSON
1358

10223

SURVEY TO LOCATE PORTIONS OF THE SOUTH & WEST
LINES OF SECTION 16, T39S, R2W, W.M.,
JACKSON COUNTY, OR.

Narrative Description to comply with Par. 209.250, O.R.S.
(Note: 1 map sheet accompanies this narrative)

FOR: Boise Cascade Corp., Timber & Wood Prod. Group. P.O. Box 100, Medford, OR.
97501
BY: Robert M. Thompson & Assoc., 1140 Acacia Lane, Grants Pass, OR. 97527

PURPOSE: As stated above

PROCEDURE: Pertinent U.S. General Land Office (G.L.O.) and Jackson County Surveyor files were copied, and studied for useable information. From the Southwest corner of said Section 16, E.D.M. Survey control traverses were run Northerly to the West $\frac{1}{4}$ Corner, and Easterly to the location for the South $\frac{1}{4}$ Corner. The last said $\frac{1}{4}$ Corner was not found (it had also been searched for by the Jackson County Surveyor's Office [Malotte & Gallegos] and not found, in 1979). Hence my survey traverse was extended Easterly to the Southeast Section Corner, and the proportioned position of said South Quarter Corner was computed. An additional search was made, without finding said Quarter Corner, so it was set. Boundaries were marked as shown on my map, with red painted blazes, red flagging, and aluminum "P/L BCC" tags.

Corners found or set are described as follows, with Original G.L.O. Bearing Trees (O.B.T.'s) and Southwest Section Corner B.T.'s measured to the faces. All other (later) bearing trees were measured to the centers:


$\frac{1}{4}$ Cor. Secs. 17 & 16 found Jackson Co. Surveyor 1" G.I. Pipe
w/1974 brass cap, and B.T.'s:
27" Y. Pine S 37°W 5.3', O.B.T., " $\frac{1}{4}$ S" scribe visible
Rotted Pine stump core S 20°E 23.1', O.B.T.
15" D. Fir N 73 $\frac{1}{2}$ °E 19.9', C.S. 1974, healed
10" D. Fir N 72 $\frac{1}{2}$ °W 15.5', C.S. 1974, healed
Cor. is 100'± N. of logging rd., cse. E'ly & W'ly

Corner Sections 16,17,20,21 found Jackson County Surveyor
1" G.I. Pipe with 1970 brass cap, and B.T.'s:
22" Y. Pine S 81°E 8.2', O.B.T., scribe vis.
28" D. Fir N 21°W 30.9' (G.L.O. 33.0') O.B.T., healed
8" D. Fir N 48 $\frac{1}{2}$ °E 20.9', C.S. 1970, healed
20" Y. Pine S 61°E 29.9', C.S. 1970, healed
13" D. Fir N 47°W 10.0', C.S. 1970, healed
8" D. Fir N 67°W 13.2', C.S. 1970, healed

$\frac{1}{4}$ Corner Sections 16/21 set 5/8" X 30" I. Rod w/yel. cap
mkd. "Thompson", scribed B.T.'s " $\frac{1}{4}$ S (Sec. No.) 1358 BT":
6" D. Fir S 6°E 16.4'
5" D. Fir North 13.1'

Corner Sections 15,16,21,22 found G.L.O. 2" B.I. Pipe with
1917 brass cap and B.T.'s:
18" B. Oak S 31°W 50.8', O.B.T., dead & down w/rotted face
20" Pine N 84 $\frac{1}{2}$ °W 128.7', 1917, dead & down, badly rotted
17" Y. Pine S 57°W 34.0', C.S. 1979, "BT" scr. vis.
8" W. Oak S 23 $\frac{1}{2}$ °E 25.3', C.S. 1979, scribe vis.
Cor. is 215'± N. of draw, cse. ESE

March 22, 1985

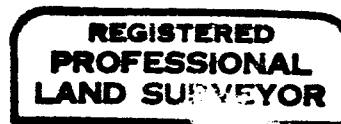

Robert M. Thompson

