


10226

SURVEY OF SOUTH LINE SEC. 34, T. 37 S., R. 3 W., W.M., JACKSON COUNTY, OREGON  
MARCH 14, 1985

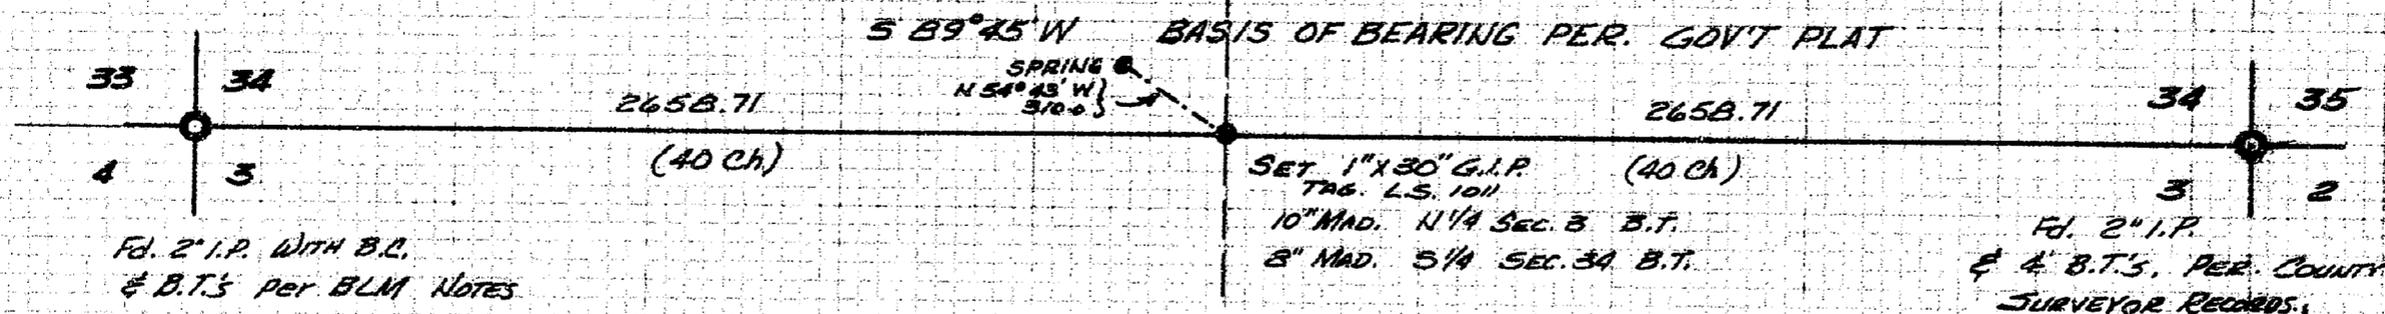

**SURVEY NARRATIVE:**

Survey for: Wayne Meeds  
2622 Forrest Creek Rd.  
Jacksonville, Ore.

Survey by: Robert Mason  
415 Surrey Dr.  
Grants Pass, Ore.

**PURPOSE of Survey:** To locate or establish the South Quarter Corner of Sec. 34.

**PROCEDURE:** A search of records in the Jackson County Surveyor's Office revealed no evidence of anyone locating or using this corner since the original government survey. I used aerial maps to locate the general area and searched for evidence of the corner. There has been logging and mining activities in this area and it appears that others, before me, have also searched without success.

Since I did not find any evidence, I measured the south line of Sec. 34 and set the corner by proportionate measurement. I, again made further investigation after determining this location and found nothing.

\*\* RECEIVED \*\*  
Date 4/5/85 By SK  
This survey consists of:  
1 sheet(s) map  
0 page(s) Narrative  
JACKSON COUNTY  
SURVEYOR

REGISTERED  
PROFESSIONAL  
LAND SURVEYOR  
*Robert Mason*  
OREGON  
JULY 22, 1974  
ROBERT MASON  
1011

1" = 500'

10226