

"B" STREET
 Fd. 3/4" I. Pipe in mon. case
 (Rec. 470.0)



SCALE 1" = 30'
 Basis of Bearings R.S. No. 6198
 o = Set 5/8"x24" I. Pin (tagged R.L.S638)

REGISTERED
 PROFESSIONAL
 LAND SURVEYOR
George Burrell
 OREGON
 JULY 10, 1964
 GEORGE R. BURRELL
 638

** RECEIVED **
 Date 5/8/85 By SK
 This survey consists of:
 1 sheet(s) Map
 SURVEYOR

MAP OF SURVEY
 Located in Lots 19, 20 and 21, Blk "Q"
 of the RAILROAD ADDN. to the City
 of Ashland in N1/2 Sec. 9, T39S, R1E
 For: ROBERT BELL
 By: George Burrell, Land Surveyor
 APR. 26, 1985

SURVEY NO. 10261

SURVEY NARRATIVE TO COMPLY WITH O.R.S. 209.250



FOR: Robert Bell
P.O. Box 541
Ashland, Ore. 97520

PURPOSE: To monument the boundaries of the tract described in
Doc. No. 84-01254 of the Official Records.

PROCEDURE: The corners of Block "Q" were determined from found
City centerline street monuments as shown on the
accompanying map. Original lot boundaries were then
determined by proportional distance as indicated on
said map. The N.W. and S.W. corners of said tract was
established at the proportional position for the original
lot line common to lots 18 and 19. The N.E. corner of
said tract was established at deed record distance from
the N.E. corner of lot 20. The S.E. corner of said tract
was established at proportional distance between the S.E.
and S.W. corner of lot 21.

BY: George Burrell, Land Surveyor
1379 Brookdale
Medford, Oregon 97504

April 26, 1985

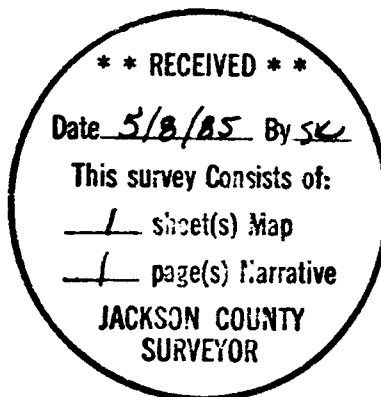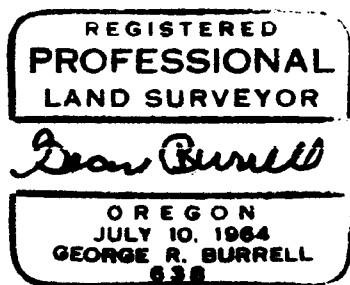

Tax Lot No. 6300-39-1E-9AC