

10302

10302

33 34
4 3

FD. brass cap 6" below
surface of parking lot &
accessories per record

S 89° 59' 23" W 2653.39

FD. 1" G.I.P. & accessories
per record.

34 1/4
3

300.00

100.00

Map of Survey

Located in the northwest quarter of Section 3, Township
34 South, Range 1 West of the Willamette Meridian,
Jackson County, Oregon.

for

Mr. John Henson

BASIS OF BEARING: Filed survey no. 9986

○ Found monuments as shown

● Set 5/8" x 24" iron pin w/yellow plastic
cap marked WEAVER L.S. 1679

SCALE: 1" = 100'

DATE: June 12, 1985

**** RECEIVED ****
Date 6/27/85 By SK
This survey consists of:
1 sheet(s) Map
1 page(s) Narrative
JACKSON COUNTY
SURVEYOR

REGISTERED
PROFESSIONAL
LAND SURVEYOR
Kurt C. Weaver
OREGON
JULY 14, 1978
KURT C. WEAVER
1679

Surveyed by: **Kurt C. Weaver**
616 China Gulch Road
Jacksonville, Oregon 97530



S 00° 41' 50" E 594.22

S 00° 41' 50" E 684.34

S 00° 41' 50" E 869.38
(rec. S 00° 43' 48" E 869.25)

N-S centerline of Section 3 per survey no. 4393

Line monuments set

4" deep

FD. 5/8" iron pin
per filed survey no. 4393

HWY. 227

HWY. 62

RIGHT OF WAY NOT LOCATED

10302 ✓

Survey No. 10302

SURVEY NARRATIVE TO COMPLY WITH O.R.S. 209.250.

Survey for: Mr. John Henson
2252 Table Rock Road Sp. 31
Medford, Oregon 97501

Location: Located in the northwest quarter of Section 3, Township
34 South, Range 1 West of the Willamette Meridian, Jackson
County, Oregon.

Purpose: To monument the northeast corner of that parcel of land
described in instrument no. 78-03958 of Official Records
of Jackson County, Oregon, and the northwest corner of that
parcel of land described in instrument no. 78-08848 of
said Official Records. The east line of the former and
the west line of the latter instruments was also monumented
at the top of a steep slope which descends toward the high-
way.

Procedure: The aforementioned northwest and northeast corners were set
on the north line of Section 3. The side lines of the
parcels, by deed are parallel to the north-south center-
line of Section 3. Monuments recovered from filed survey
no. 4393 were used to control said north-south centerline.
As per said survey no. 4393 the South quarter corner of
Section 3 lies in the Rogue River, therefore the found
monument was used to control the line.

The highway right of ways were not located, and are shown
only for graphic purposes.


Bearing was based on filed Survey no. 9986.

Surveyed by: Kurt C. Weaver
616 China Gulch Road
Jacksonville, Oregon 97530

Date: June 12, 1985

REGISTERED
PROFESSIONAL
LAND SURVEYOR

Kurt C. Weaver
OREGON
JULY 14, 1978
KURT C. WEAVER
1679

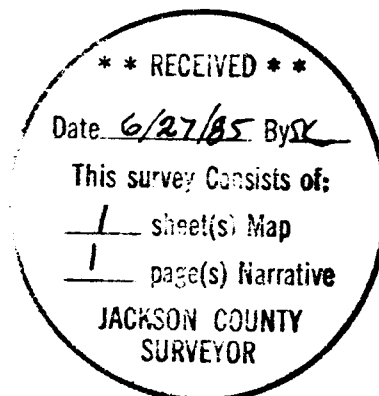

341W 38 T.L. 200, ⁴⁰² 400 & 401