

BASIS OF BEARINGS: R.S. 8729

** RECEIVED **
 Date 7/19/85 By SE
 This survey consists of:
 1 sheet(s) Map
 JACKSON COUNTY
 SURVEY

RECEIVED
 FEDERAL BUREAU OF LAND MANAGEMENT
 Daniel W. Edwards
 DANIEL W. EDWARDS
 7/21

SURVEY FOR: Joseph Ruell		
SCALE: 1" = 600'	() Record Data	DRAWN BY: D.A.E.
DATE: March 1, 1985		REVISED
LOCATED in Donation Land Claim No. 41 and the NW 1/4 of Section 14, T. 35 S., R. 1 W., W.M. in Jackson County, Oregon		
● Monument found as noted		DRAWING NUMBER
○ 5/8" x 24" steel pin with plastic cap set		

SURVEY NO. 10318

SURVEY NARRATIVE TO COMPLY WITH PARAGRAPH 209.250, O. R. S.

SURVEY FOR: Joseph Ruell
1020 Butte Falls Hwy.
Eagle Point, Ore. 97524

survey by; Darrel W. Edwards
2346 Springbrook
Medford, Ore. 97504



PURPOSE: Survey tract of land per deed records.

PROCEDURE: Traversed between government corners re-established by Jackson County Surveyor. Made diligent search for South 1/4 corner of Section 14. Finding no evidence I calculate the proportionate position of said South 1/4 corner. Calculated North-South center line of Section 14 to determine deed tie to subject property. Set new property corners as shown on the accompanying plat as per deed records.

EQUIPMENT: Lietz TM-20C theodolite, Red-1 E.D.M. and 200' steel tape.

BASIS OF BEARINGS: R.S. 8729

DATE COMPLETED: March 1, 1985.

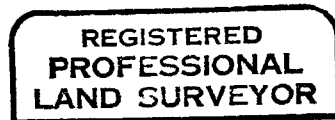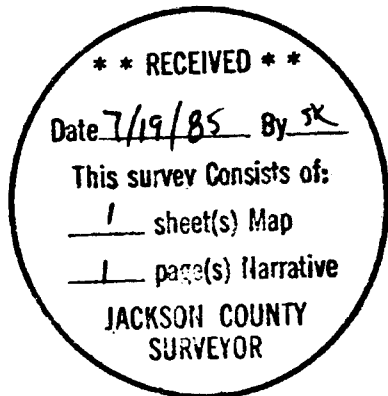

Darrel W. Edwards

