

- LEGEND:
- ⊙ = FD. GOV'T. CORNER MONUMENTED BY CO. SURVEYOR'S OFFICE.
 - ⊕ = FD. 5/8" IRON PIN WITH PLASTIC CAP STAMPED KAISER R.L.S. 803
 - ⊗ = FD. 3/4" I. PIPE / 2" BRASS CAP STAMPED WITH CORNER DESIGNATION & R.L.S. 803
 - = SET 5/8" IRON PIN WITH PLASTIC CAP STAMPED FRIAR P.L.S. 961
 - X-X-X BARBED WIRE FENCE

**** RECEIVED ****
 Date 8/14/85 By SK
 This survey consists of:
 / sheet(s) Map
 / parolary Narrative
 JACKSON COUNTY SURVEYORS

REGISTERED
PROFESSIONAL
 LAND SURVEYOR
 LARRY J. FRIAR
 OREGON
 LARRY J. FRIAR
 961

MAP OF SURVEY
 FOR
WESTERN BANK

LOCATED IN THE N.E. 1/4 OF SECTION 16, T.37S.,
 R.1E., W.M., JACKSON COUNTY, OREGON.
 SCALE: 1" = 200'
 DATE: AUGUST 1, 1985
 BASIS OF BEARING: SURVEY NO. 10224
 BY: FRIAR-MOFFIT & ASSOCIATES
 MEDFORD, OREGON

37S, 1E, SEC. 16, T.L. 220

Survey No. 10332

Survey Narrative to comply with O.R.S. 209.250

Survey For: Western Bank
P.O. Box 1377
Coos Bay, Or. 97420



Location: N.E. 1/4 of Section 16, T. 37S., R. 1E.,
W.M., Jackson Co., Oregon.

Purpose: To monument the corners of the parcel of
land described in Instrument No. 85-05590
O.R.

Procedure: A random traverse was conducted in the
N.E. 1/4 of Section 16 utilizing an Electronic
Total Station, tying to corners established by
Survey No.'s 9920 and 10224, and setting
control points near corners to be established.
After determining that the monuments set
by those surveys were accurately placed the
parcel shown on the annexed map was monumented
using the information shown on those surveys

Date: August 13, 1985

Larry J. Friar
Friar-Moffit & Assoc.
717 W. 10th St.
Medford, Or. 97501

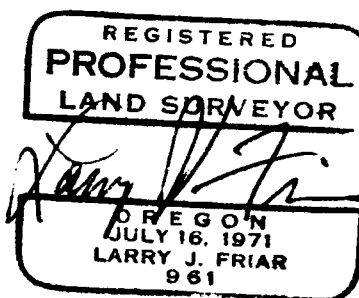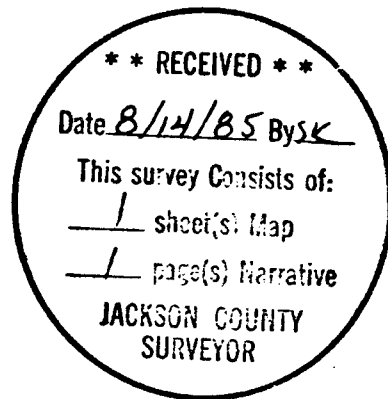

37S, 1E, Sec.16, T.L.220