


10353

10353

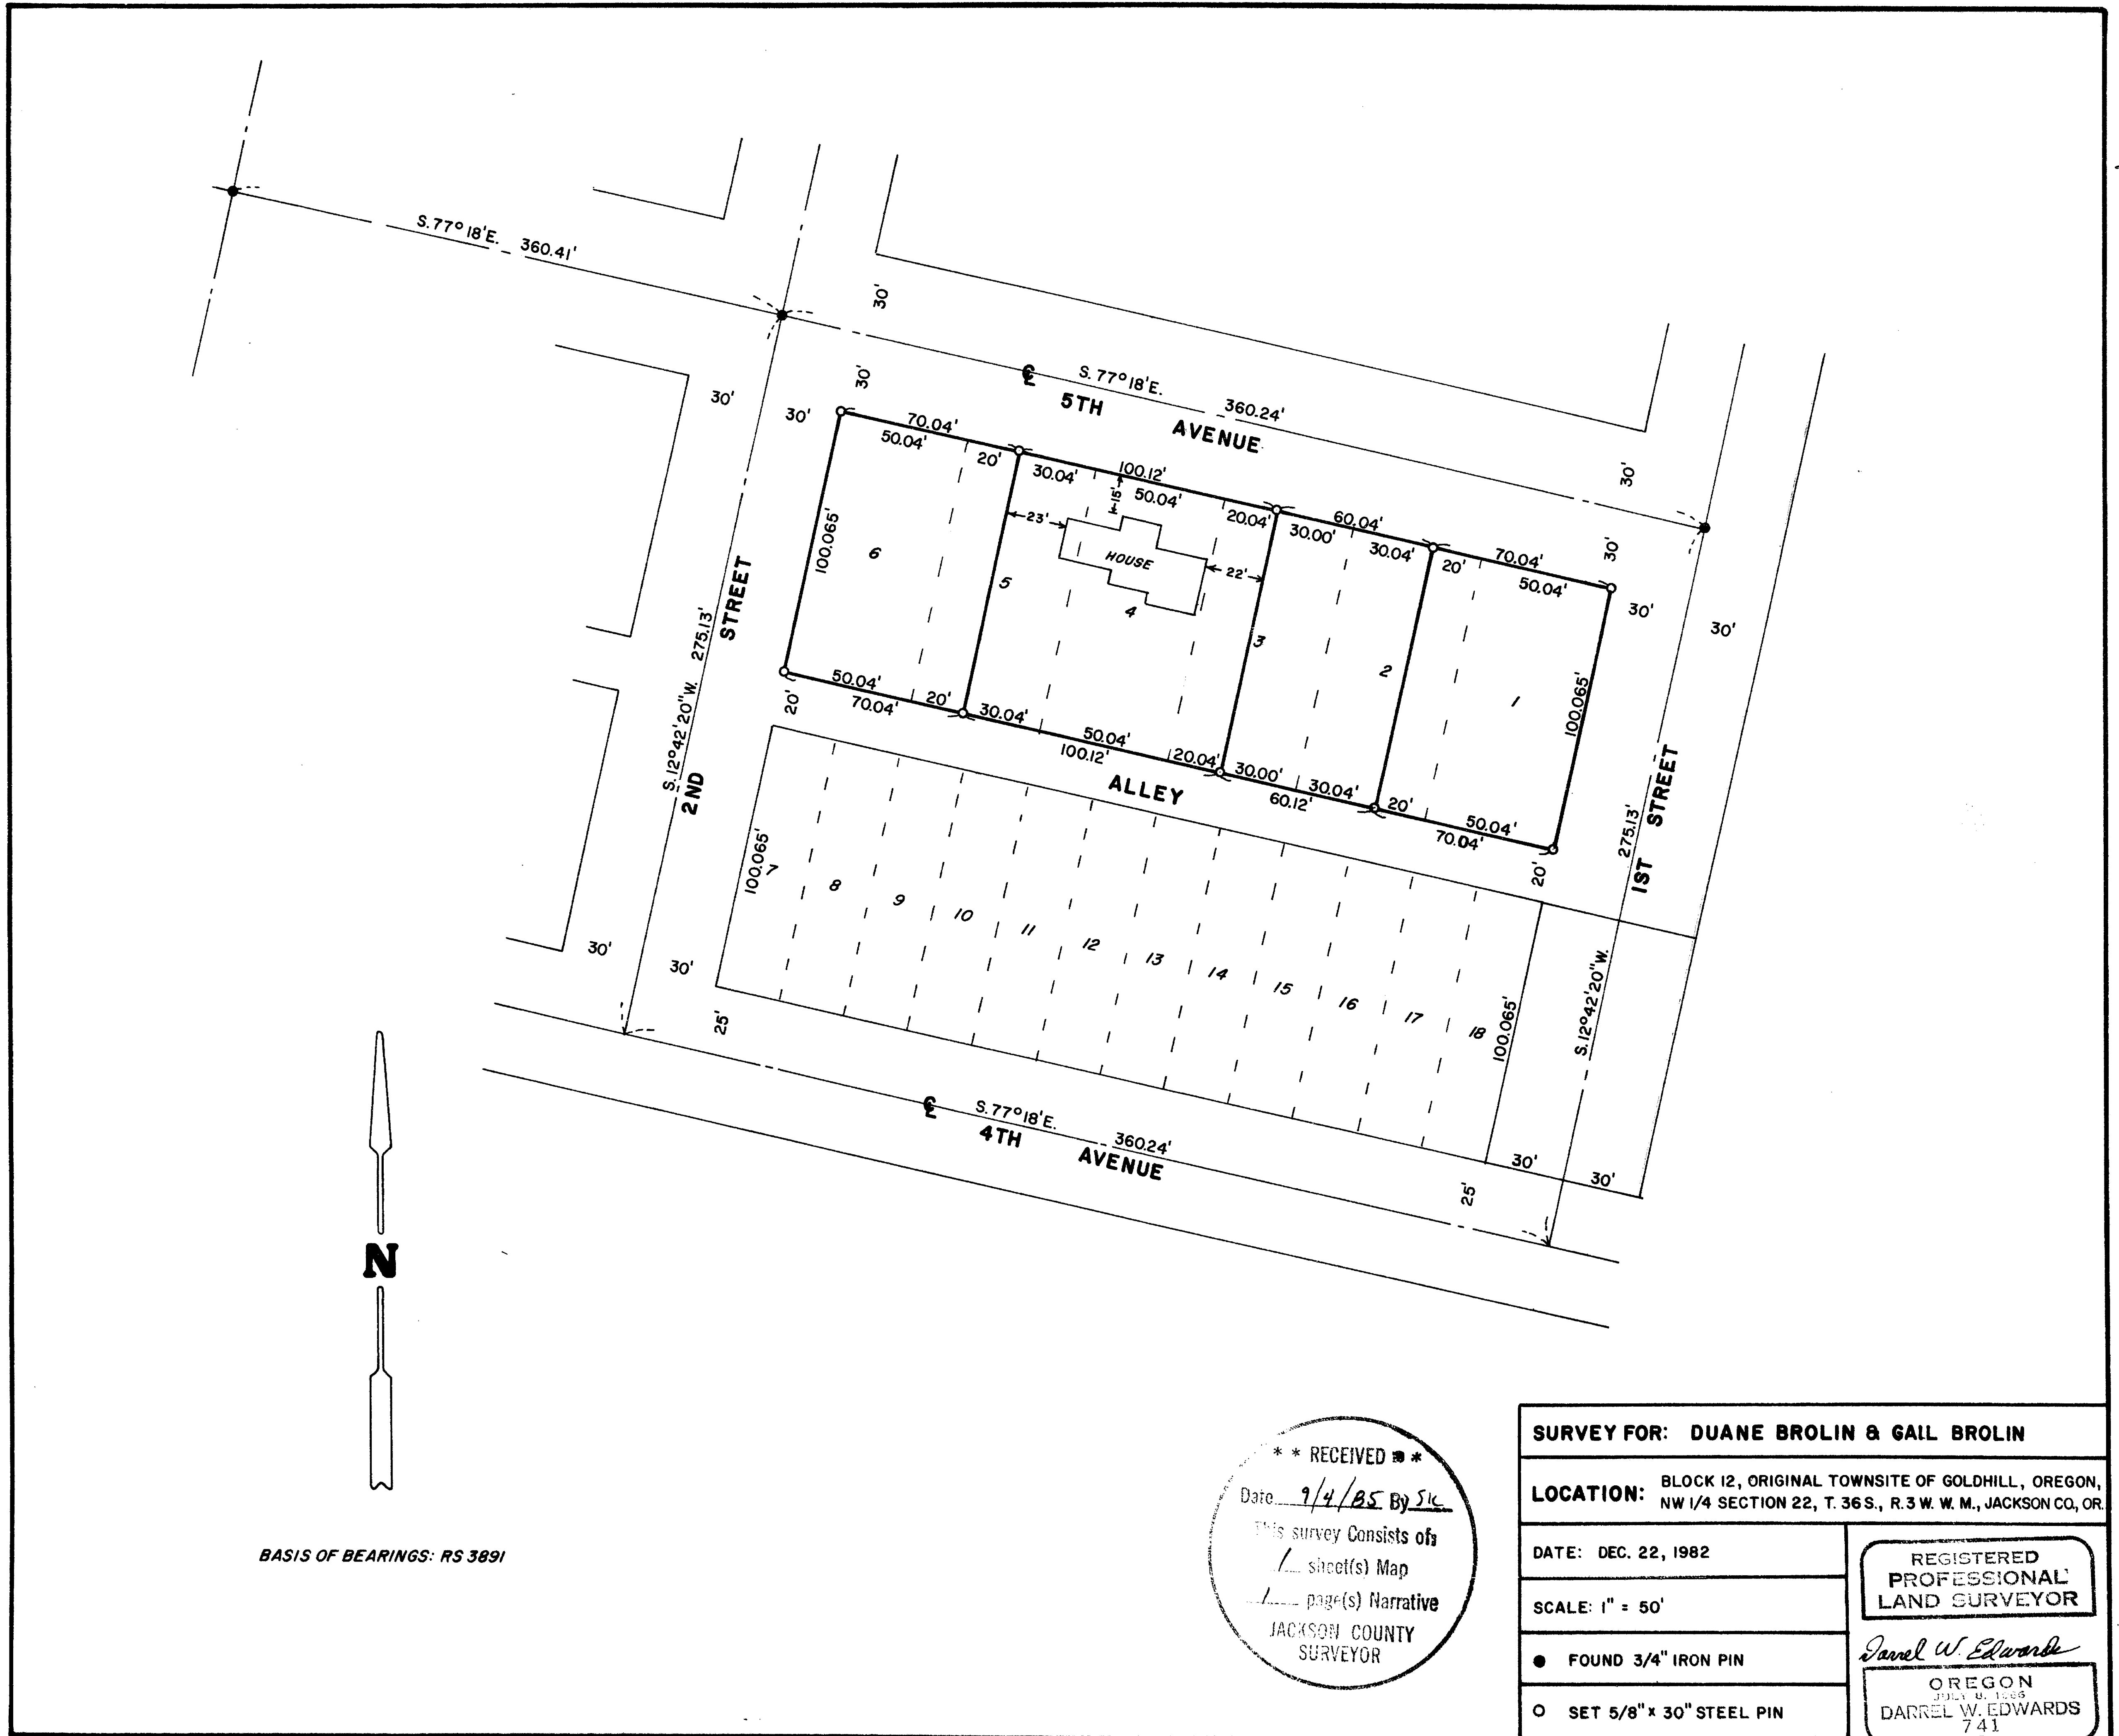

36-3X 22 BA

10353

SURVEY NO. 10353

SURVEY NARRATIVE TO COMPLY WITH PARAGRAPH 209.250, O. R. S.

SURVEY FOR: Duane Brolin and Gale Brolin
1601 NE Sixth Street
Grants Pass, Ore. 97526

LOCATION: Block 12, Original Townsite of Goldhill, Oregon.
Northwest 1/4 of Section 22, Township 36 South, Range
3 West of the Willamette Meridian, Jackson County, Ore.

PURPOSE:: Create 1/4 parcel of land out of 6 original lots as
platted.

PROCEDURE: Found center line control monuments per RS 3891.
Set new property corners as shown on the accompanying
plat. Set 5/8" by 30" steel pins with plastic caps
stamped "DW EDWARDS - LS 741".

EQUIPMENT: Lietz TM 20C, Lietz Red-1 EDM and 200' steel tape.

BASIS OF BEARINGS: RS 3891.

DATE: Sept. 4, 1985.

SURVEY BY: Darrel W. Edwards
2346 Springbrook
Medford, Ore. 97504
phone 776-2313

Darrel W. Edwards
Darrel W. Edwards
Registered Professional
Land Surveyor No. 741

