

MAP OF SURVEY
 Located in Lot 86 SKY CREST EST.
 SUBD. UNIT 2 in Sec. 23, T37S, R1W.M.
 For: RICKY DORMAN
 By: George Burrell, L.S. 8/23/85

SURVEY NO. 10359



SURVEY NARRATIVE TO COMPLY WITH O.R.S. 209.250

FOR: Ricky Dorman
1522 Angel Crest Dr.
Medford, Ore. 97504

PURPOSE: To monument the corners of tax lot no. 196-37-1W-23C.

PROCEDURE: The monuments found along the centerline of Angel Crest Drive and original lot corners of lots 85 and 86 were held as control for establishing said lot boundaries according to deed record. The monuments found at the Southwesterly boundary of said lot were apparently set during the course of a previous survey by persons unknown (survey unrecorded).

BY: George Burrell, Land Surveyor
1379 Brookdale
Medford, Ore. 97504
Aug. 23, 1985

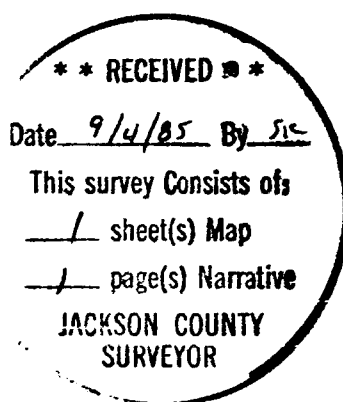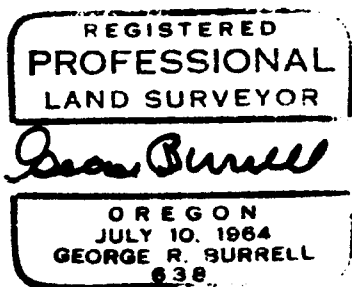

Tax Lot No. 196-37-1W-23C