

Fd. 5/8" I. Pin per R.S. No. 9098

S.E. Cor. Govt. Lot No. 3 Fd. 5/8" I. Pin per R.S. No. 8973

S 89° 58' 14" W South line Govt. lot 3 per R.S. 6782



SCALE 1"=100'

Basis of Bearings R.S. No. 6782

LEGEND

- = Set 5/8" I. Pin (tagged R.L.S 638)
- = Fd. 5/8" I. Pin
- D.R. = Deed record

REGISTERED
PROFESSIONAL
LAND SURVEYOR

George Burrell

OREGON
JULY 10, 1964
GEORGE R. BURRELL

** RECEIVED **

Date 9/4/85 B.B.S.



MAP OF SURVEY

Located in S.E. 1/4 Section 21, T34S, R1W
For: B. L. WILLIAMS
By: George Burrell, L.S. 8/15/85

SEC. COR.
Fd. C.S. Br. Capped Pipe

SURVEY NO. 10360

SURVEY NARRATIVE TO COMPLY WITH O.R.S. 209.250

FOR: B.L. Williams
7358 Capistrano Drive
Burnaby, British Columbia
Canada V5A 1P8

PURPOSE:

To monument the exterior boundaries of the Williams ownership and to redescribe tax lots 800,900, 902 and tracts A and B as shown on the accompanying map for probate purposes. A redescription was necessary due to the overlap of tax lot no. 900 upon the tract described in Volume 247, Page 49 of the deed records of J. C. O. (tracts A and B as shown on the accompanying map are remnant parcels occurring from the conveyance of a portion of the tract described in Volume 247, Page 49 of said deed records to Dale Sattler in 1971).

PROCEDURE:

The South boundary of the tract described in Volume 247, Page 49 of said deed records and the South boundary of the Dale Sattler property was located according to deed record. The tract described in Volume 234, Page 59 said deed records (tax lot no. 900) being senior and partitioned from the tract described in Volume 91, Page 264 of said deed records was established according to deed record by first adjusting the tract description for closure (Vol. 91, Pg. 264) by the Compass Rule.

A search was made for evidence of corners or lines of this tract, but due to changes in the course of Rogue River and the 1964 flood, no evidence was found. As the parent tract was created in 1911 and was apparently surveyed on the ground by link chain (implied by the description) and as the error of closure of said description would be in the error range expected, the description was adjusted for closure by the Compass Rule.


This adjustment in position results in closer agreement with the present improvements between the boundaries of tax lots 900,700 and 701. Tax lots 800 and 902 are remnant parcels and were located according to deed record from the parent parcel descriptions. The existing Crater Lake Highway right of way was established from found monuments of Survey No. 6782 and the approx. center of the existing pavement.

BY: George Burrell, Land Surveyor
1379 Brookdale
Medford, Ore. 97504
Aug. 15, 1985

REGISTERED
PROFESSIONAL
LAND SURVEYOR

George Burrell

OREGON
JULY 10, 1964
GEORGE R. BURRELL
638

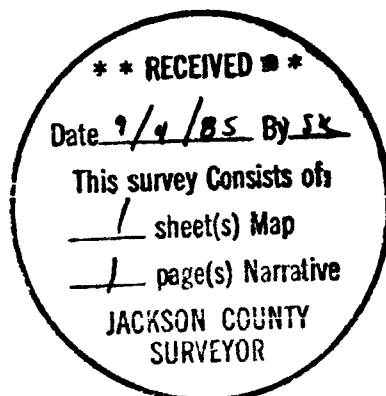

Tax Lots 900,800,902-34-1W-21D