
N
 BASIS OF BEARINGS: R. S. 7181

** RECEIVED **
 Date 10/22/85 D.W.E.
 This survey consists of:
 1 sheet(s) Map
 1 page(s) Narrative
 JACKSON COUNTY
 SURVEYOR

REGISTERED
 PROFESSIONAL
 LAND SURVEYOR
Darrel W. Edwards
 OREGON
 JULY 8, 1983
 DARREL W. EDWARDS
 741

SURVEY FOR: Wm. E. "Pete" Price		
SCALE: 1" = 60'	<input checked="" type="checkbox"/> Survey Monuments Found <input type="checkbox"/> Set 5/8" x 24" Steel Pin <input type="checkbox"/> Denotes Deed Record Call	DRAWN BY D.W.E.
DATE: 10 - 4 - 85		
LOCATION: SW 1/4 of Section 15, T. 34 S., R. 1 W. W. M., Jackson County, Oregon, NW 1/4 of Section 22, CITY OF SHADY COVE, ORE.		
SURVEY BY: Darrel W. Edwards P. O. Box 801 Rogue River, Ore.	Ph. 582-3091 Ph. 776-2313	DRAWING NUMB

SURVEY NO. 10383

SURVEY NARRATIVE TO COMPLY WITH PARAGRAPH 209.250, OREGON REVISED STATUTES.

SURVEY FOR:: Wm. E. "Pete" Price
PRICELESS HOMES, Inc.
Crater Lake Highway
White City, Oregon

LOCATION: The Southwest 1/4 of Section 15 and the Northwest 1/4 of Section 22, Township 34 South, Range 1 West of the Willamette Meridian in the City of Shady Cove, Jackson County, Oregon.


PURPOSE: Two minor Land Partitions creating 5 individual tax lots in the City of Shady Cove, Oregon.

PROCEDURE: Ran traverse between Section corner to quarter corner between Sections 15 and 22. Calculated position and set Northwest corner of the Northeast 1/4 of the Northwest 1/4 of the Northwest 1/4 of Section 22. Blazed 15" Oak S. 53° 25' W. 23.70 feet and a 12" Pine N. 31° 35' W. 6.56 feet.
Set pins as shown on the accompanying plat. Set 5/8" x 24" steel pins with plastic caps stamped "DW EDWARDS - LS 741".

BASIS OF BEARINGS: R.S. 7181

DATE: 10-4-85

SURVEY BY: Darrel W. Edwards
P. O. Box 801
Rogue River, Ore. 97537
Phone 582-3091 or 776-2313

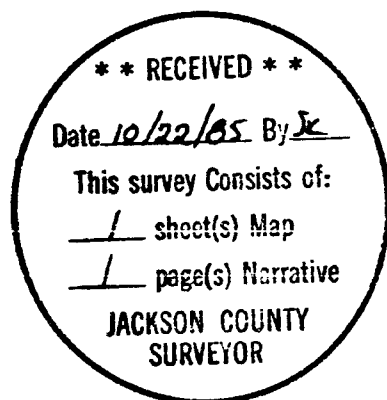

REGISTERED
PROFESSIONAL
LAND SURVEYOR

Darrel W. Edwards
OREGON
JULY 8, 1966
DARREL W. EDWARDS
741

T. 34 - 1 W., 15, T.L. 1101
T. 34 - 1 W., 22, T.L. 1900