


PLAT

SHOWING A SURVEY IN SECTION 12,
T.40S., R.2 W., W.M., JACKSON COUNTY,
OREGON.

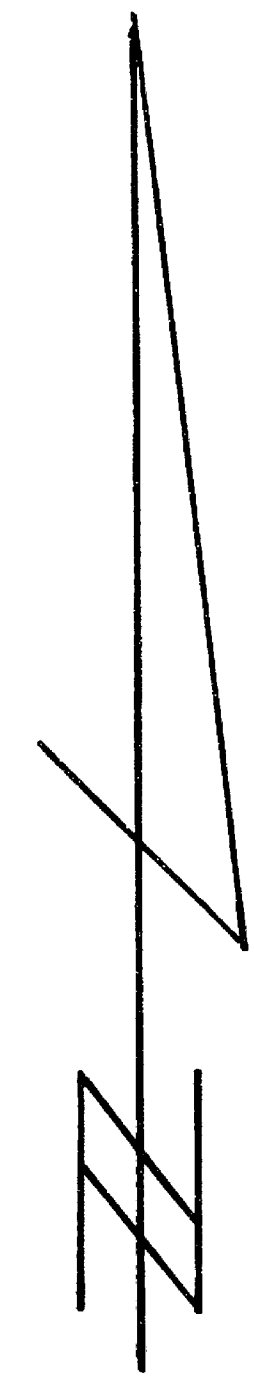

MERIDIAN BASED ON SOLAR
OBSERVATION.

LEGEND

- ⊙ FOUND BRASS CAP MONUMENT.
- SET 5/8" X 30" IRON ROD/PLASTIC CAP.
- BLAZED LINE.

REGISTERED
PROFESSIONAL
LAND SURVEYOR
Gerald V. Nygren
OREGON
GERALD V. NYGREN
AUGUST 22, 1975
1035

** RECEIVED **
Date 11/15/85 By SK
This survey consists of
1 sheet(s) Map
1 page(s) Narrative
JACKSON COUNTY
SURVEYOR

SURVEYED FOR: TIMBER PRODUCTS CO. 25 E. McANDREWS RD. MEDFORD, OREGON 97501	GERALD V. NYGREN 522 BARKER DRIVE PH476-7034 MERLIN, OREGON 97532	DATE: SEPT. 29, 1985 SCALE: 1" = 500' JOB NO. 85-21
--	--	---

10401

SURVEY NARRATIVE

DATE: September 29, 1985.

SURVEYED FOR: Timber Products Company
25 E. McAndrews Road
Medford, Oregon 97501

SURVEYED BY: GERALD V. NYGREN
522 Barker Drive
Merlin, Oregon 97532

LOCATION: Section 12, Township 40 South, Range 2 West,
Willamette Meridian, Jackson County, Oregon.

PURPOSE: Mark the North Half of the North-South Centerline
and the East Half of the East-West Centerline of
said Section 12.

PROCEDURE: Beginning at the North Quarter corner of said Section
12 which is monumented as shown on Plat, thence I
traversed South $0^{\circ}22'53''$ East, 5248.90 feet to the South
Quarter corner of said Section 12 which is monumented
as shown on Plat. Thence I traversed from the West
Quarter Corner which is monumented as shown on Plat,
North $88^{\circ}29'42''$ East, 5292.48 feet to the East Quarter
corner of said Section 12 which is monumented as shown
on Plat. I then set the Center Quarter corner as shown on
Plat and blazed lines for logging.

A Wild T-16 Theodolite and A MAC 1E EDM were used to
execute this survey.

Meridian is based on Solar Observation.

