
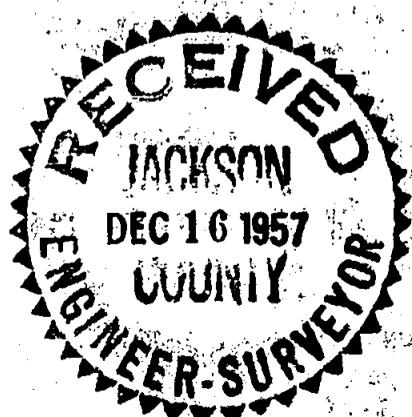



1045

Survey For
WATKINS CONSTRUCTION CO.
 of Lot 6, Block 63, Original Town of
 Medford, Oregon
 By: Mark E. Boyden
 Sept. 1957.

SCALE : 1" = 60'

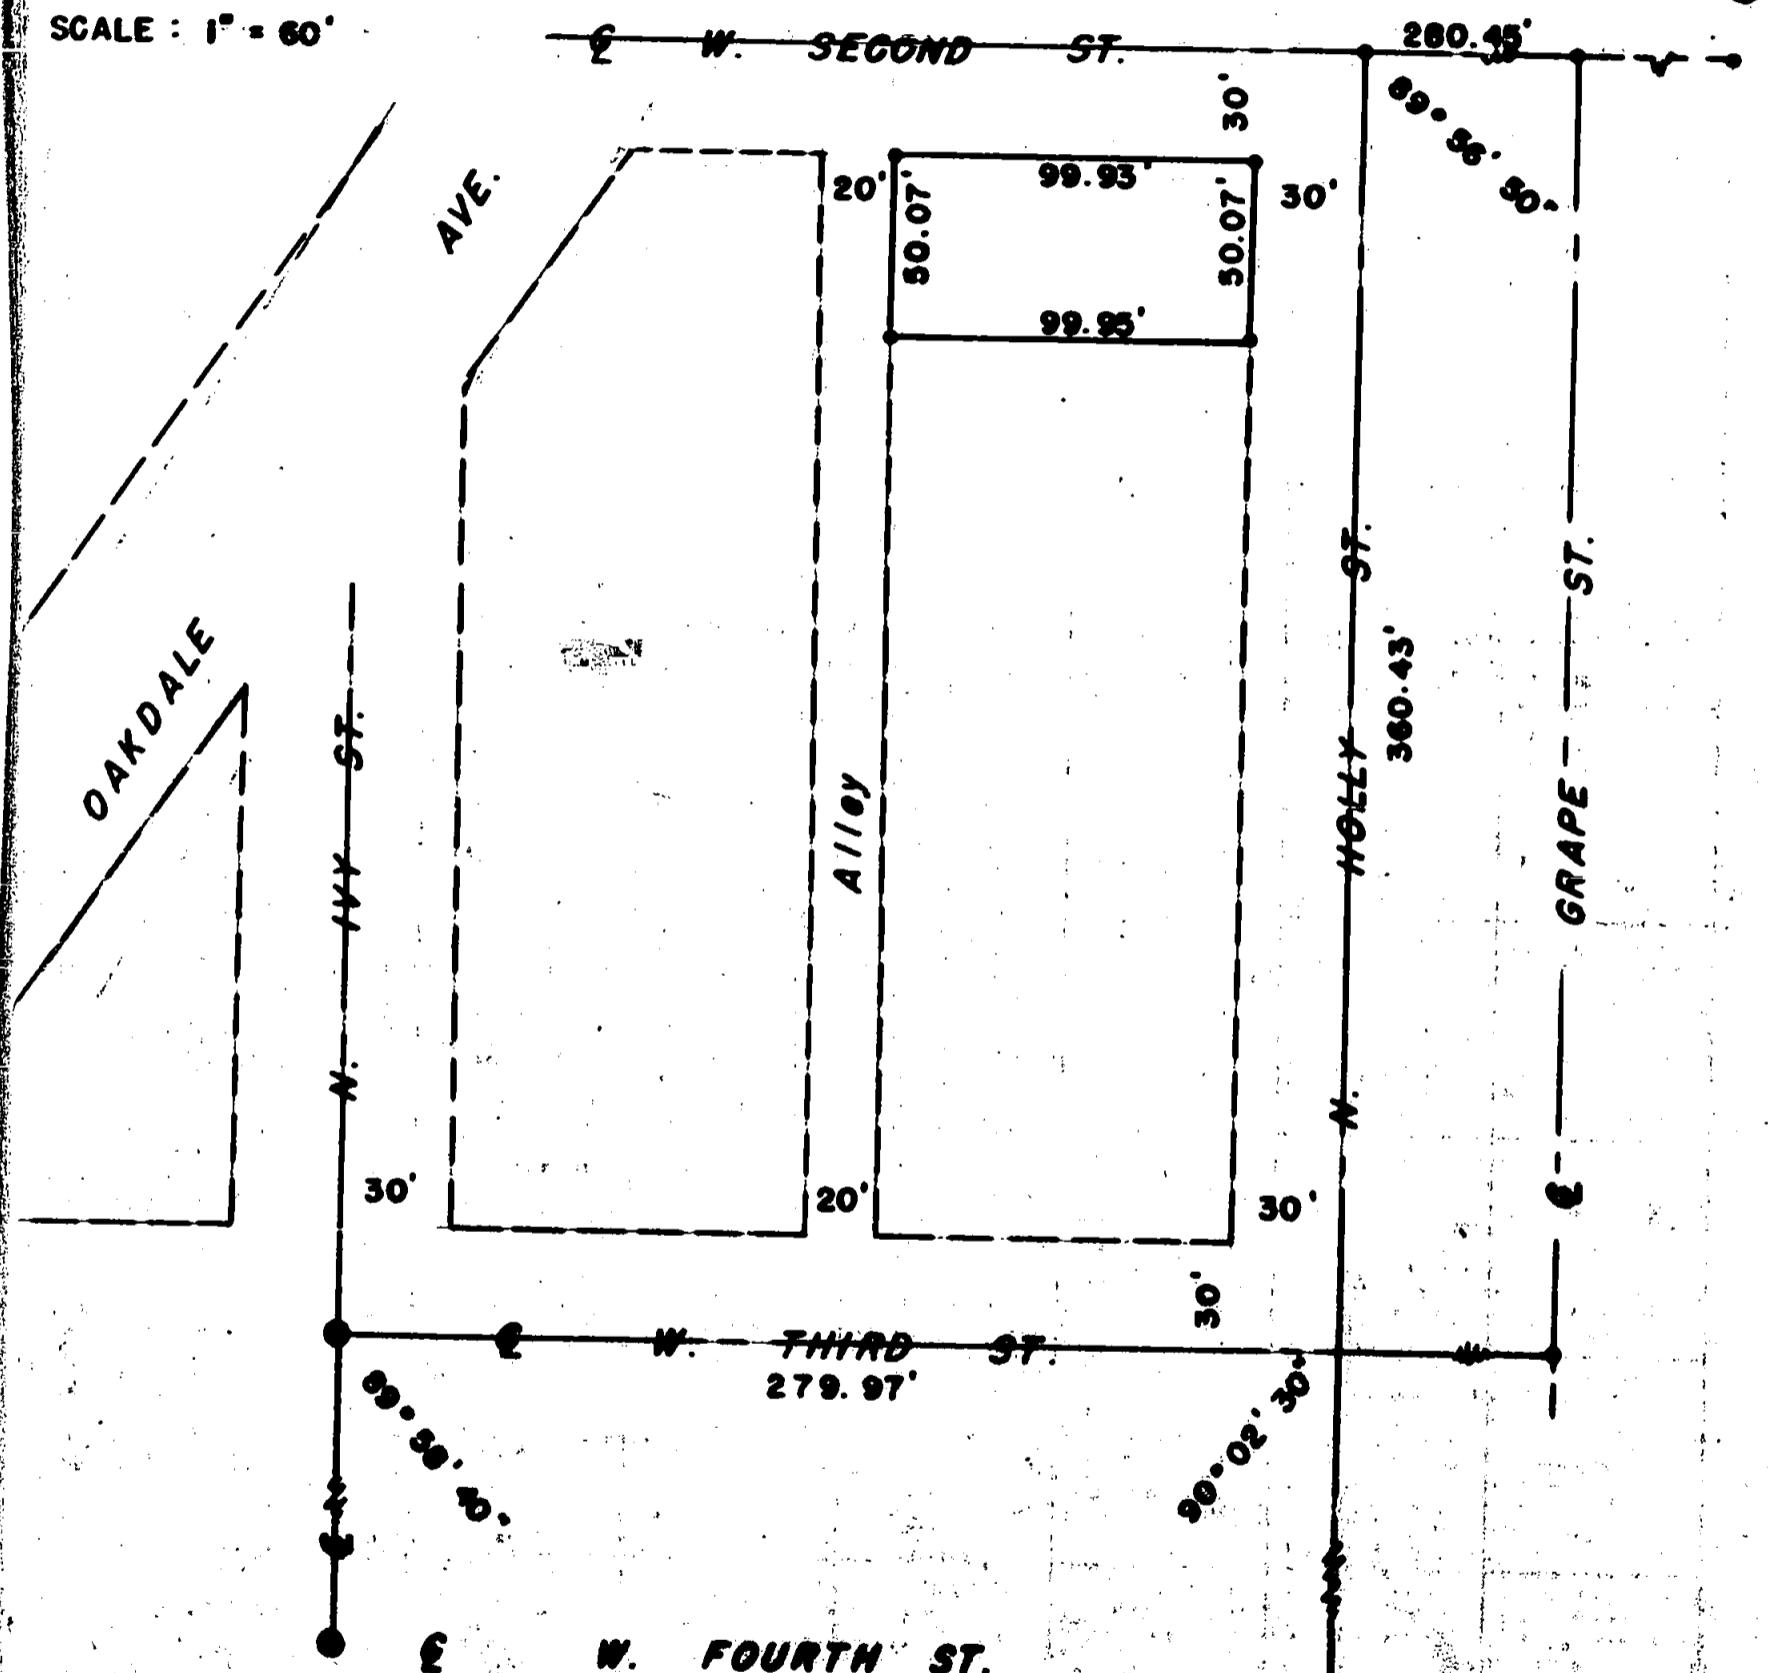

- FG. concrete markers
- FG. iron pin
- Set S/I 100 ft

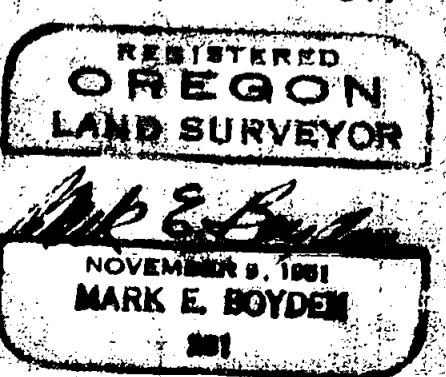

Survey Narrative to Comply with Paragraph 209.250,
Oregon Revised Statutes

FOR: Watkins Construction Company

PURPOSE: To monument the corners of Lot 6, Block 63 of the
Original Town of Medford, Oregon

PROCEDURE: Holly Street centerline was established from the iron
pins found at Second and Sixth Streets. (the intervening streets
originally marked with crosses on the monument case ring were
considered unreliable as they appear to have shifted when raised.)

The other Street centerlines were cut-in or projected
from monuments found to theoretically close Block 63, irrespective
of Oakdale Avenue.

The desired lot boundaries were then proportioned as
shown.

September 1957

