

SCALE 1" = 500'  
 Basis of Bearings R.S. No. 10386  
 o = Set 5/8" x 24" Pin (tagged R.L.S. 630)

REGISTERED  
**PROFESSIONAL**  
 LAND SURVEYOR  
*George Burrell*  
 JACSON COUNTY  
 SURVEYOR

RECEIVED  
 Date 3/13/86 By RE  
 This survey consists of:  
 \_\_\_ sheet(s) Map  
 \_\_\_ page(s) Narrative  
 JACSON COUNTY  
 SURVEYOR

**MAP OF SURVEY**  
 Located in Sections 5 and 7, T39S, R2E  
 For: JIM MILLER  
 By: George Burrell, R.L.S. Feb. 1986

SURVEY NARRATIVE TO COMPLY WITH O.R.S. 209.250

FOR: Jim Miller  
975 Dead Indian Rd.  
Ashland, Oregon

PURPOSE: To monument the corners and mark the lines of the clients ownership in section 5 and 7, T39S, R2E.

PROCEDURE: The basis of bearing for this survey is the true meridian as determined by recorded survey no. 10386 at a point 1600 feet East of the 1/4 corner common to sections 4 and 5.



The section corner common to sections 5, 6, 7 and 8 was restored by double proportionate measurement. This corner position falls in the center of what appears to be the original remains of the rock mound. No original evidence was found at the West 1/4 corner of section 5 and the four 1/4 corners of section 7.

The 1/2" iron pipe found at the Southwest corner of section 7 was accepted as the best evidence of the original corner position (all four original bearing tree's are gone). The single proportionate position for this corner as determined from the nearest found corners (2 miles South and 1 mile North) falls 15.2 feet South and 9.4 feet East of the found 1/2" iron pipe. L.E. Ager's records indicate that he found this 1/2" pipe in 1953 and later reported it in recorded survey no. 2100.

Sections 5 and 7 were subdivided as shown on the accompanying map from which the interior corners were monumented and lines marked with wood stakes.

BY: George Burrell, R.L.S.  
1379 Brookdale  
Medford, Oregon 97501

Mar. 13, 1986

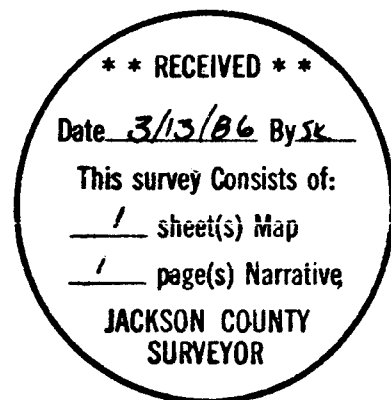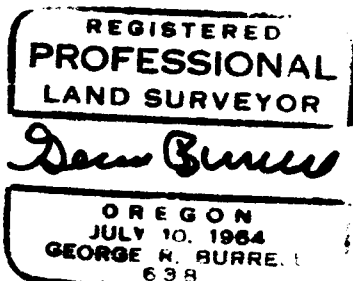

T.L. 400-39-2E-5  
T.L. 100-39-2E-7