


Survey For
THE CENTRAL POINT CHURCH
 OF CHRIST
 Located in Lots 9-14, Block 2 of
 the Original Town of Central Point,
 Oregon, By: Mark E. Boyden, Sept. 1957

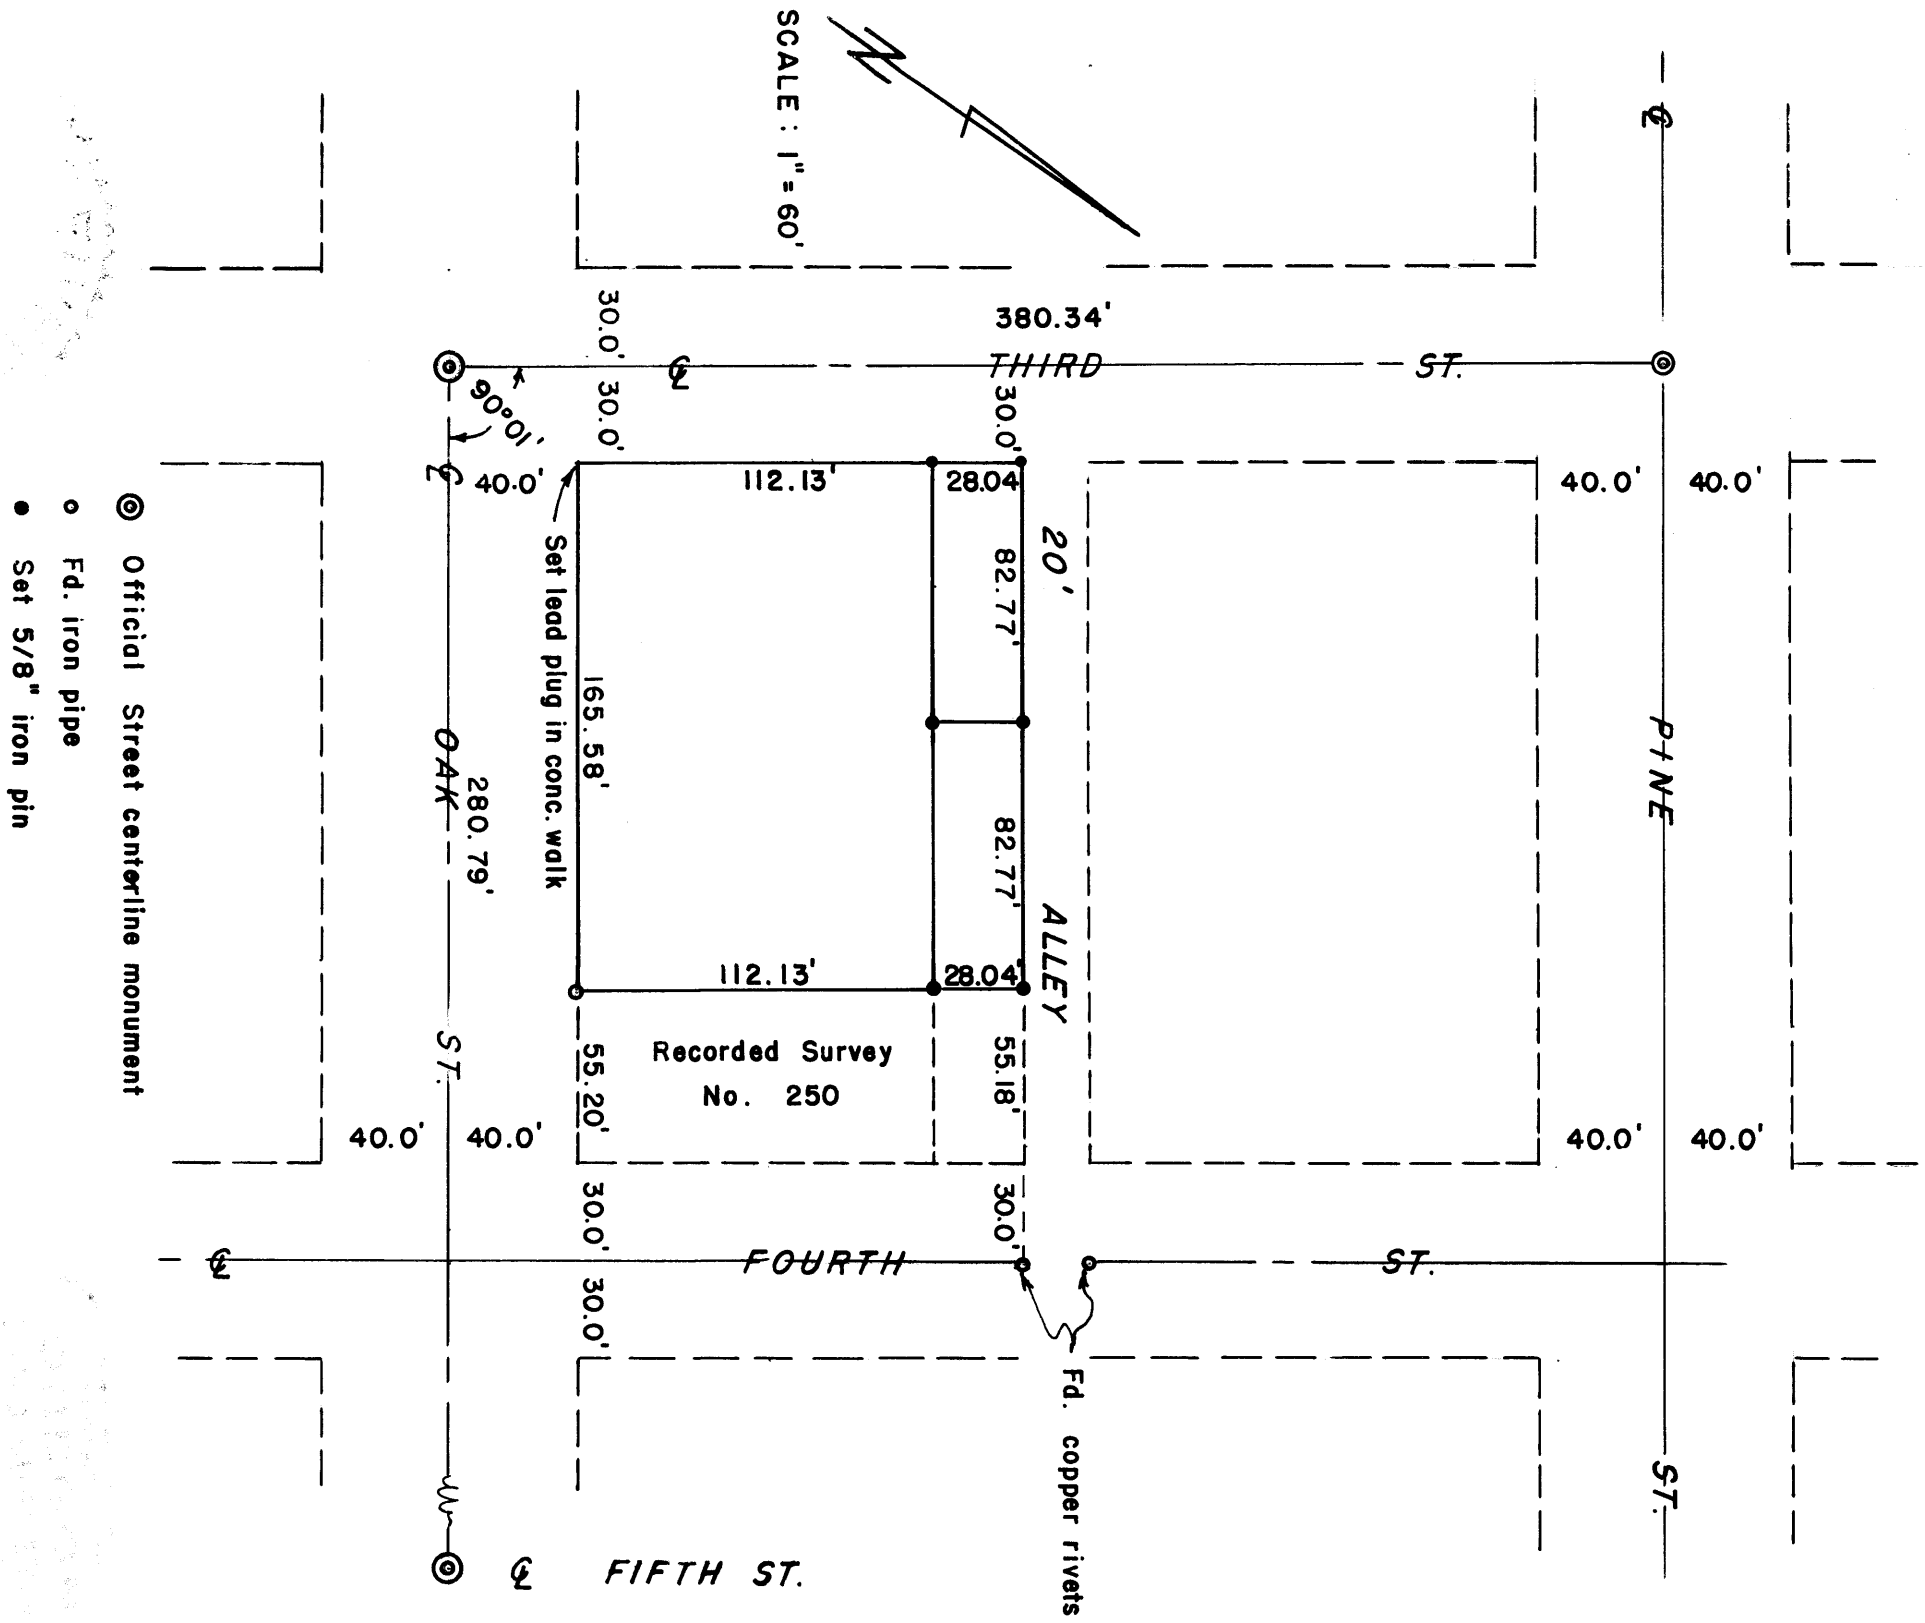

- ⊙ Official Street centerline monument
- Fd. iron pipe
- Set 5/8" iron pin

Mark E. Boyden

Survey Narrative to Comply with Paragraph 209.250,
Oregon Revised Statutes

FOR: Central Point Church of Christ

PURPOSE: To monument the exterior boundaries of Lots 9-14, Block 2 of the Original Town of Central Point, Oregon, also monumenting the Northerly 28.04 feet in two equal parcels for an exchange of deeds.

PROCEDURE: Recovered the Street monuments shown, re-chaining the Third and Oak Street sides of said Block to further check recorded Survey No. 250. Then monumented the tracts as shown, considering the "North 28 feet and the South 112 feet" as recorded in Deed Records be proportional.

September 1957

