

Map of Survey

Located in the southeast quarter of Section 5, Township 40 South, Range 3 West of the Willamette Meridian, Jackson County, Oregon.

for

JACK CRAMER

BASIS OF BEARING: Filed Survey No. 8683
 O Found monuments as shown.
 ► Set "T-type" steel fence post.
 SCALE: 1 inch = 50 feet
 DATE: March 19, 1986



REGISTERED
 PROFESSIONAL
 LAND SURVEYOR
Kurt C. Weaver
 OREGON
 JULY 14, 1978
 KURT C. WEAVER
 1679

Surveyed by: Kurt C. Weaver
 616 China Gulch Road
 Jacksonville, Oregon 97530

*** RECEIVED ***
 This survey consists of:
 1 sheet(s) Map
 1 page(s) Narrative
 JACKSON COUNTY
 SURVEYOR

CNS 1/64

Survey No. 10511

SURVEY NARRATIVE TO COMPLY WITH O.R.S. 209.250.

Survey for: Mr. Jack Cramer
P.O. Box 788
Medford, Oregon 97501

Location: Located in the southeast quarter of Section 5, Township
40 South, Range 3 West of the Willamette Meridian,
Jackson County, Oregon.

Purpose: To mark the west line of the northwest quarter of the
northwest quarter of the southeast quarter of said
Section 5, and to set a line marker on the north line
of said southeast quarter.

Procedure: This section had been previously subdivided by me in
1980, during the performance of filed survey number
8683. By utilizing survey control from said survey no.
8683 for bearing and coordinate basis I established the
relationship of those monuments found and shown on the
accompanying map.


Steel "T-type" fence posts were set along the line and
the distances between same are displayed on the accom-
panying map. These posts were set at intervisible inter-
vals if trees and brush were removed.

Surveyed by: Kurt C. Weaver
616 China Gulch Road
Jacksonville, Oregon 97530

Date: March 19, 1986

REGISTERED
PROFESSIONAL
LAND SURVEYOR

Kurt C. Weaver
OREGON
JULY 14, 1978
KURT C. WEAVER
1679

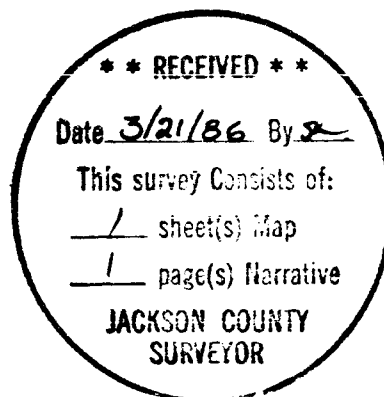

Tax lot 1500
T405 R3W Sec. 5