
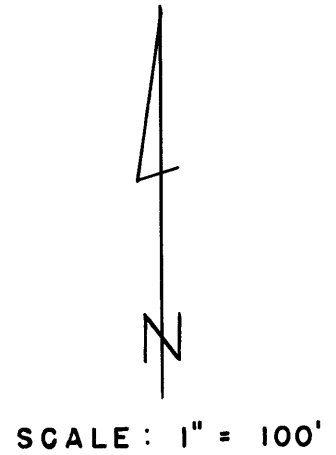


ey For  
 ALD HERRIED et al.  
 22, T.37 S.R.1W., W.M.  
 1,2,17 HILLCREST HEIGHTS  
 Mark E. Boyden Sept. 1957.

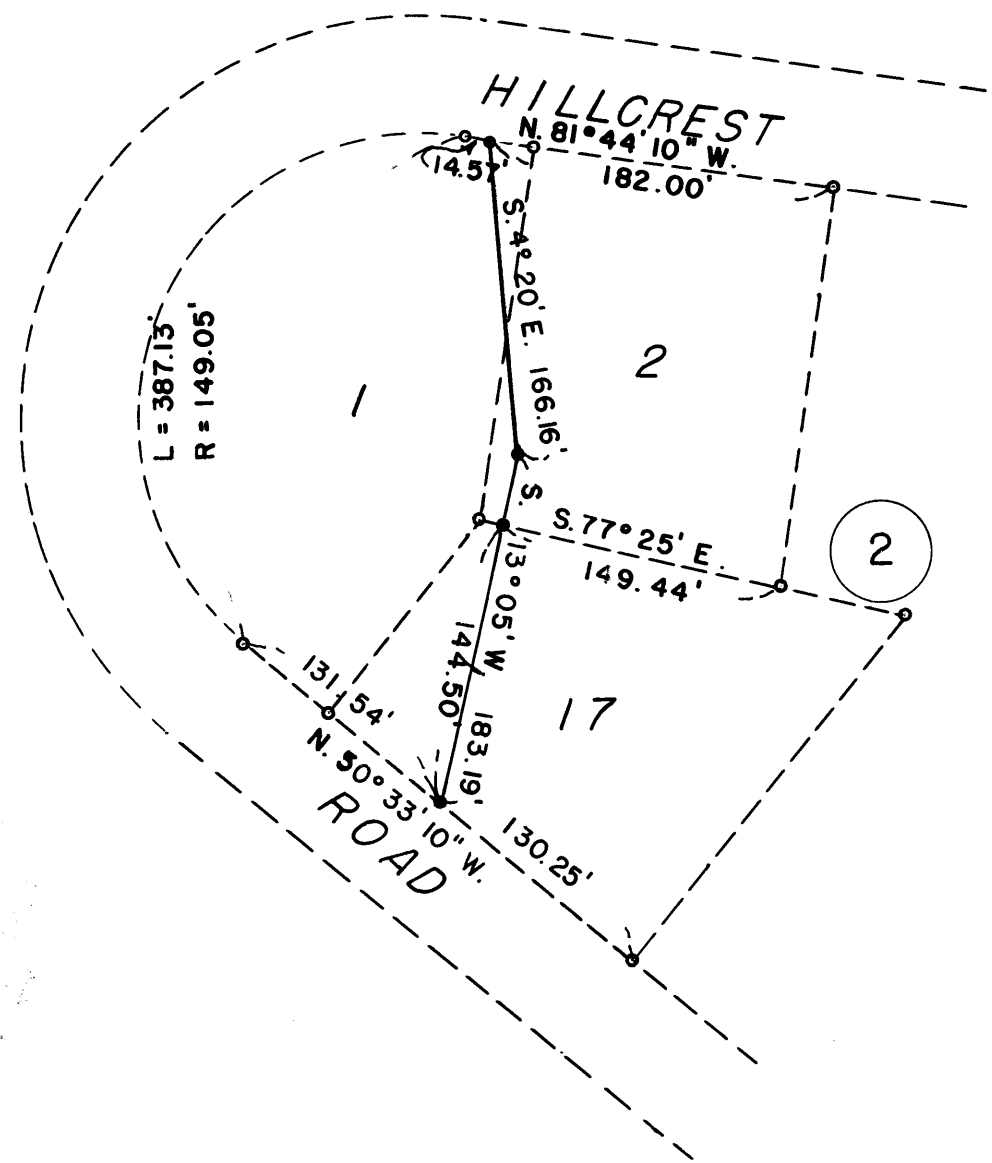

- Fd. iron pin or bolt
- Set 5/8" Iron pin

Mark E. Boyden  
 Surveyor

Survey Narrative to Comply with Paragraph 209.250,  
Oregon Revised Statutes

FOR: Donald Herried et al

PURPOSE: To monument and prepare new descriptions resulting from  
a change in the East boundary of Lot 1, Block 2 of  
HILLCREST HEIGHTS.

PROCEDURE: Found the existing lot corner monuments, establishing  
the new boundary as shown.

September 1957

