

NE COR D.L.C. 50  
FD. 1 1/2" GI PIPE

MAP OF SURVEY

LOCATED IN

**\*\* RECEIVED \*\*** N.W. 1/4 SEC. 32, T37S, R1W, W.M.  
Date 5/6/86 By JL

JACKSON COUNTY OREGON

This survey Consists of:

- 1 sheet(s) Map
- 1 page(s) Narrative

JACKSON COUNTY  
SURVEYOR

FOR

**JACK UNDERWOOD**  
6366 Old Stage Road  
Central Point, Oregon 97502

Scale: 1" = 50'

Basis of Bearing East Line of DLC #50 per RS #5566


- Set 5/8"x24" Iron Pin
- Found Monument as Noted
- Nothing Found or Set

W.C. Witness Corner

- Canal
- ( ) Record

Surveyed By:

**ROGER KAUBLE & ASSOCIATES**  
PO Box 1252  
Ashland, Oregon 97520  
April 7, 1986

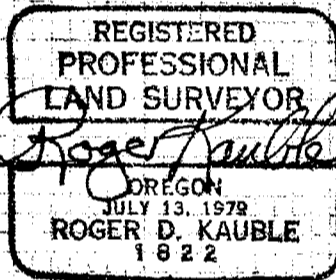

FD. 5/8"  
I. PIN,  
NO CAP

221.36'

954.77'

954.85'

FD. 1" PIN IN MON

S89°58'00"W

CASE

0.03'  
(SEE RS#  
3866)

**BARNETT ROAD**

30.00'

TAX LOT 400

TAX LOT 500

APPROX CANAL LOCATION

- (1) N 53° 45' E 36.6'
- (2) N 88° 36' E 45.3'
- (3) S 84° 48' E 76.9'
- (4) S 76° 47' E 72.1'
- (5) S 53° 43' E 21.1'

S00°01'00"E

137.80'

S89°58'00"W 150.00'  
CANAL (DR WEST)

S00°01'00"E

15.00'

S89°58'00"W

100.00'

S06°01'00"E

30.00'

TAX LOT 300

2' WC. (DR EAST) S89°58'00"W

250.00'

S00°01'00"E 122.80'

30.00'

**ELLENDALE DRIVE**

10542

10542

37 1W 32 06

Survey No. 10542

SURVEY NARRATIVE TO COMPLY WITH PARAGRAPH 209.250  
OREGON REVISED STATUTES

Survey for: Jack Underwood  
6366 Old Stage Road  
Central Point, Oregon 97502

Location: Northwest quarter of Section 32, Township 37 South,  
Range 1 West, Willamette Meridian, Jackson County,  
Oregon.

Purpose: To establish and monument the corners of tax lot #500  
as shown on map 371W32BA and described by the docu-  
ment recorded as 79-21874 of Jackson County Official  
Records.

Procedure: The east boundary of D.L.C. No. 50 (also the center-  
line of Ellendale Drive) was established by using the  
N.E. Corner of D.L.C. No. 50 and the 1" iron pin  
located at the intersection of Barnett Road and  
Ellendale Drive. This line established the basis of  
bearing and is parrallel to the east line of the deed  
parcel. The brass disk located in the centerline of  
Barnett Road at the Bear Creek bridge was searched  
for, but not recovered by this survey.

Iron pin monuments were set as shown on the accom-  
panying plat; a witness monument was set at the  
southwest corner of the parcel as the position for  
this corner fell in a 10 inch diameter Cedar. Also,  
no monument was set for the most northeasterly corner  
as this position falls in the center of an existing  
ditch.

Basis of  
Bearing: East Line of D.L.C. No. 50 as per Record of Survey  
#5576.

April 7, 1986

Roger Kauble, PLS #1822  
P. O. BOX 1252  
Ashland, Oregon 97520

