

10543

SURVEY PLAT AND NARRATIVE TO COMPLY WITH PARAGRAPH 209.250,
OREGON REVISED STATUTES.

Survey for: John M. & Vionna V. O'Brien
2081 Knowles Road
Medford, OR 97501

Purpose : To monument the north line
of O.R. 83-10227

Procedure : Orientation with monuments
of record.

Bearings : Based on the two monuments
shown hereon per Survey No.
4433.

REGISTERED
PROFESSIONAL
LAND SURVEYOR

Charles H. Hurst

OREGON
OCTOBER 30, 1959
CHARLES H. HURST
483


April 9, 1986

SURVEY SITUATE IN THE NE¼ OF SEC. 4,
T. 38 S., R. 2 W., W.M.,
JACKSON COUNTY, ORE.

Survey by:
Charles H. Hurst
765 Sunrise Ave.
Medford, OR 97504



Basis of Brgs.
Survey No. 4433

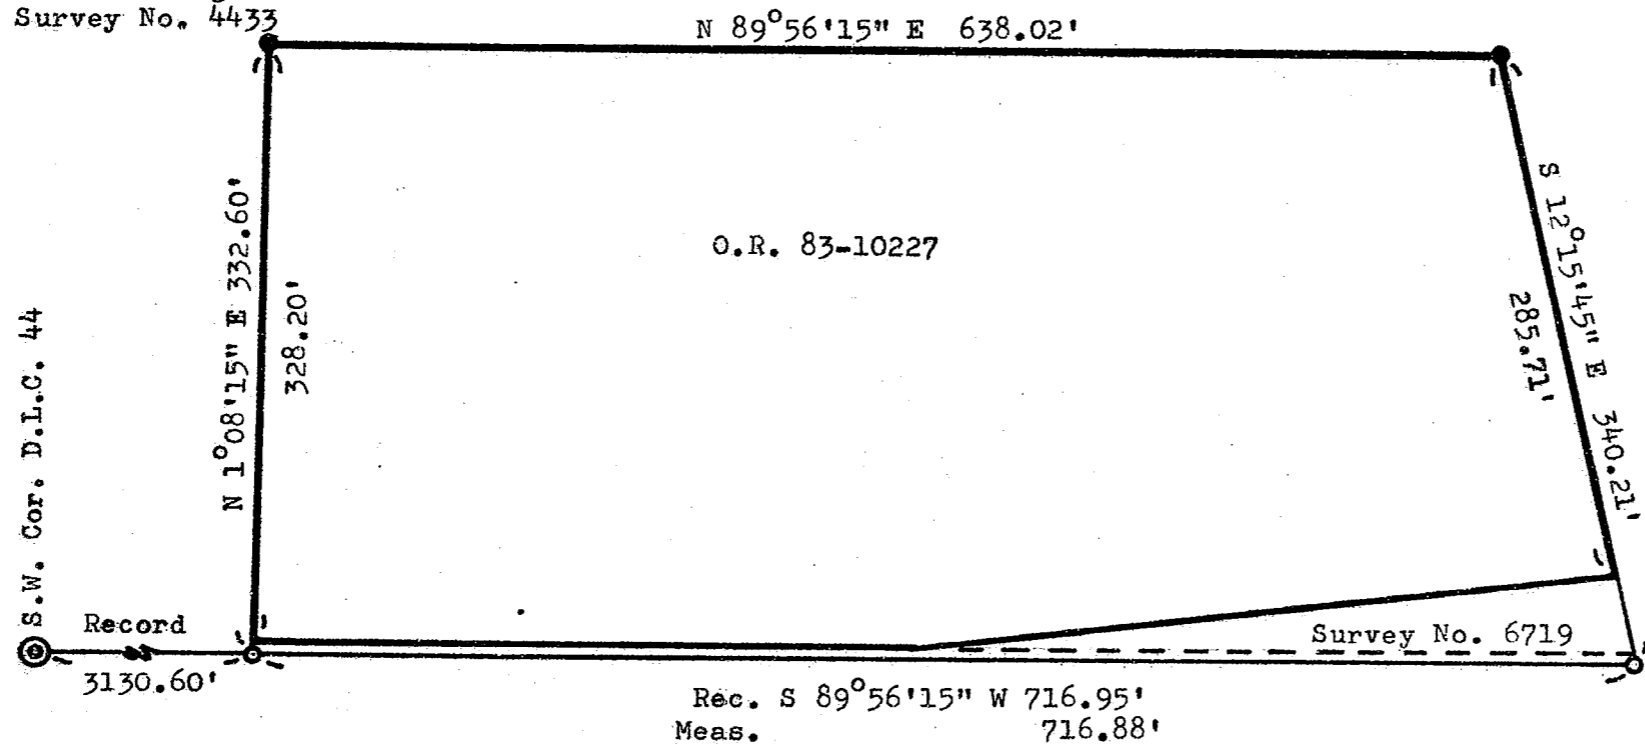

LEGEND

- Set 5/8" x 24" iron pins
- Fd. 5/8" iron pins per Survey No. 4433

**** RECEIVED ****
 Date 4/24/86 By CH
 This survey consists of:
1 sheet(s) Map
0 page(s) Narrative
 JACKSON COUNTY
 SURVEYOR

382W4

10543