

OAKDALE AVE

SW cor. D.L.C. 44  
T.37S.R.1W.

N 89° 59' E

1782.56

STEWART

102.94

AVE.

Survey For  
SCHOOL DISTRICT 549C  
Located in D.L.C. No. 45, Sec. 31, T.37S.R.1W.  
By: Mark E. Boyden  
Oct. 1957.

West boundary of the East half of the William Wright D.L.C.  
S. 0° 03' E.

286.71'

330.0'

L = 58.43' N. 89° 57' E. 13.36'  
L = 101.00'  
R = 507.47'

N 89° 59' E  
72.94'  
S 0° 03' E  
002'

L = 140.58'  
R = 447.47'  
S 17° 57' W  
52.44'


SOUTH HOLLY ST.

S 0° 03' E 330.0' to P.C.

S. 0° 03' E.

Fd. iron pin P.T.

SCALE : 1" = 100'

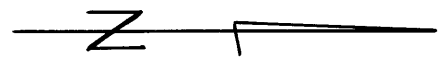

- Fd. iron pipe
- Set 5/8" iron pin
- ⊙ Fd. conc. mon.

*Mark E. Boyden*

Fd. angle  
iron on South

Survey Narrative to Comply with Paragraph 209.250,  
Oregon Revised Statutes

FOR: School District No. 549-C

PURPOSE: To monument the Easterly corners of that property described in Jackson County Deed Records Volume 412, Page 321 after the South 58.30 feet was segregated and transferred to Harry & David, An Oregon Corporation.

PROCEDURE: Found control monuments and set 5/8" iron pins as shown.

November 1957

REGISTERED  
OREGON  
LAND SURVEYOR  
*Mark E. Boyden*  
NOVEMBER 9, 1957  
MARK E. BOYDEN

RECEIVED  
JACKSON  
DEC 16 1957  
COUNTY  
ENGINEER-SURVEYOR