

SURVEY NO. 10063 & 10441

E.N.E. COR.

D.L.C. 38

1140.20'

S83°31'09"E

N38°25'13"E

242.0' (REC.)

45.73'

10566

REGISTERED
PROFESSIONAL
LAND SURVEYOR

Martin C. Stewart

OREGON
JULY 15, 1983
MARTIN C. STEWART
2057

397.17'

S41°45'08"W



LEGEND:

- = FOUND 5/8" I. PIN WITH ALUMN. CAP MKD. M.C. STEWART RLS 2057
- = SET 5/8" I. PIN WITH ALUMN. CAP MKD. M.C. STEWART RLS 2057

S14°01'21"W 194.24'

** RECEIVED **
 Date 5/21/86 By SL
 This survey consists of:
 - sheet(s) Map
 - original Narrative
 JACKSON COUNTY
 SURVEYOR

MAP OF SURVEY
FOR

ROBERT E. MARTINDALE

LOCATED IN D.L.C. NO. 38, T. 38S., R. 4W.,
W.M. JACKSON CO. OREGON.

DATE: APRIL 1986 SCALE 1" = 50'
BASIS OF BEARING: SURVEY NO. 10063

38 4W 22

SOUTH

APPLEGATE RIVER

99501

Survey No. 10563

Survey Narrative to comply with O.R.S. 209.250

Survey For: R.E. Martindale
3010 Humbug Creek Road
Applegate, OR 97530



Location: A portion of D.L.C. No. 38,
Township 38 South, Range 4 West,
Willamette Meridian, Jackson County,
Oregon.

Purpose: To establish property corners and
inherent property lines for a Boundary
Line Agreement, as per client's instructions.

Procedure: Recovered monuments from County Survey
No. 10063 were used to establish position
and basis of bearings, notably the most
Southwesterly and Southeasterly property
corners. The survey was executed with a
Topcon GTS-2B Total Station.

Surveyed By: Martin C. Stewart
717 W. 10th St.
Medford, OR 97501

Date: May 19, 1986

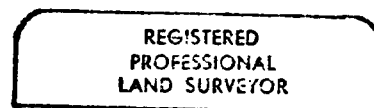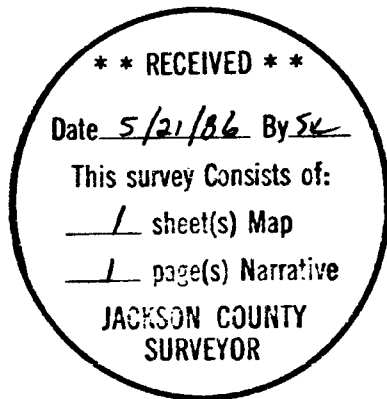

Martin C. Stewart

