

FD. 1 1/4" IRON PIPE.

S 89° 56' 05" W 988.53'

FD. BRASS CAP MARKING THE N.E. COR. D.L.C. NO. 45.



960.17'

S 02° 04' 55" W 55.00'

N 89° 50' 00" E

200.00' 150 L.M. HOUSE

50.00'

S 02° 04' 55" W 50.00'

MONUMENTS COR.

N 89° 50' 00" E

150.00' 100 L.M.

N 89° 50' 00" E

50.00'

S 02° 04' 55" W 60.00'

SURVEY NO. 8244

30'

HOYT LANE

30'

SURVEY NO. 9972

REGISTERED PROFESSIONAL LAND SURVEYOR

Lloyd R. Moffit
OREGON
JULY 27, 1970
LOYD R. MOFFIT
944

** RECEIVED **
Date 6/19/86 By SK
This survey consists of:
1 sheet(s) Map
1 page(s) Narrative
JACKSON COUNTY SURVEYOR

LEGEND:

- = FOUND MONUMENT AS SHOWN.
- = FOUND 5/8" IRON PIN.
- = SET 5/8" IRON PIN WITH PLASTIC CAP STAMPED, MOFFIT PLS 944.

BASIS OF BEARINGS:

SURVEY NO. 2542.

PLAT OF SURVEY FOR

EVELIO VIRAMONTES

BEING A PORTION OF D.L.C. NO. 45
IN THE N.E. 1/4 OF SEC. 8, T. 38S., R. 1W., W.M.
JACKSON CO. DATE: JUNE, 1986
OREGON SCALE: 1" = 40'

PREPARED BY: FRIAR-MOFFIT & ASSOC.
MEDFORD, OREGON

10583

Survey No. 10583

Survey Narrative to correct Survey No. 10583



Survey For: Evelio Viramontes
372 Hoyt Lane
Medford, OR 97501

Location: A portion of Donation Land Claim No. 45
in the Northeast one-quarter of Section 8,
Township 38 South, Range 1 West, Willamette
Meridian, Jackson County, Oregon.

Purpose: A drafting error was made on the North
line and the West end of the Southerly
line of the map of Survey. I have corrected
the distances on the map.

Date: June, 1986

Loyd R. Moffit
Friar-Moffit & Assoc.
717 W. 10th St.
Medford, OR 97501

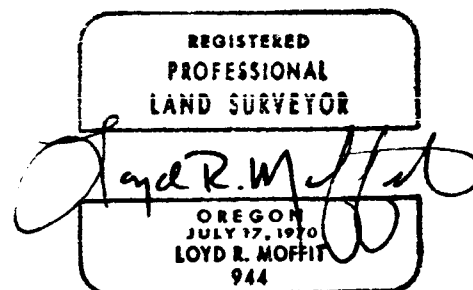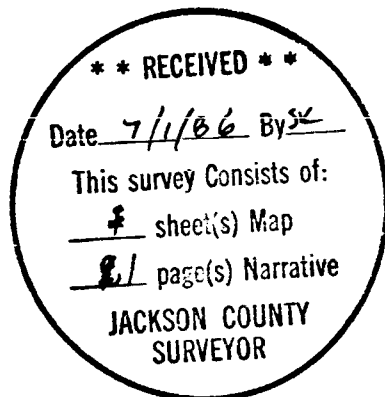

Survey No. 10583

Survey Narrative to comply with O.R.S. 209.250

Survey For: Evelio Viramontes
372 Hoyt Lane
Medford, Or 97501

Location: A portion of Donation Land Claim No. 45
in the Northeast one-quarter of Section 8,
Township 38 South, Range 1 West, Willamette
Meridian, Jackson County, Oregon.

Purpose: To survey, monument and plat the client's
property.

Procedure: Using control established by this office
during Surveys No. 8244 and 9972, I set the
corners as shown on the attached map.

Date: June, 1986

Loyd R. Moffit
717 W. 10th St.
Medford, OR. 97501

