

1062

Survey No. _____

Paul Rynning
County Surveyor
Medford, Oregon

Subject: Restoration of obliterated corner


Township 35 South, Range 3 West, Willamette Meridian
1/4 corner between Section 1 and 12.

Found original BT scribe on a 12 in. laurel snag near stump, which
bears S 20 W, 32 lks.

Found original 24 in. laurel stump N 41 W, 41 lks.

Marked 16 in. black oak, with 2 blazes N 10 W, 61 3/4 lks.

Marked 10 in. laurel, 2 blazes and BT S 22 W, 29 lks.

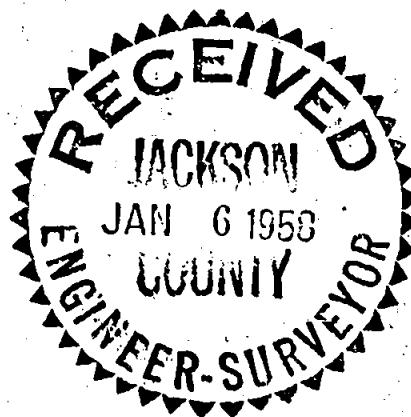

Edward A. McGinty 12/21/57

