

N. 80° 15' E.
103.29'

5/8" IRON ROD
R.S. 6665



**** RECEIVED ****
 Date 8/25/86 By sc
 This survey consists of:
 - sheet(s) Map
 - page(s) Narrative
 JACKSON COUNTY
 SURVEYOR

BASIS OF BEARINGS: R.S. 6665

SURVEY FOR: SAM GUILBERT	
SURVEY BY: DARREL W. EDWARDS	
BLOCK 1, GEORGE R. BALLS ADDITION. LOCATION: N.W. 1/4 OF SEC. 22, T. 36 S., R. 4 W. W.M., CITY OF ROGUE RIVER, JACKSON CO., OREGON	
DATE: JULY 29, 1986	REGISTERED PROFESSIONAL LAND SURVEYOR <i>Darrel W. Edwards</i>
SCALE: 1" = 40'	
• SURVEY MARKERS FOUND	OREGON JULY 8, 1983 DARREL W. EDWARDS 741
○ SET 5/8" x 24" STEEL PIN	

36 47 22 33 10661

SURVEY NO. 10661

SURVEY NARRATIVE TO COMPLY WITH PARAGRAPH 209.250, OREGON REVISED STATUTES.

SURVEY FOR: Sam Guilbert
3075 Wards Creek Road
Rogue River, Oregon 97537

LOCATION: Northwest 1/4 of Section 22, Township 36 South, Range
4 West of the Willamette Meridian in Jackson County,
Oregon.



PURPOSE: Survey Tax Lot No. 2300 as shown on the accompanying
plat.

PROCEDURE: Survey markers found or set in Registered Survey No.
6665 were used for control to make this survey. As
shown in Registered Survey No. 6665, some of the streets
and alleys as improved do not agree with the original
plat. The city attorney has corrected this problem and
a master copy of corrections made is fo record at Rogue
River City Hall. I aquired a copy of said master copy
and used dimensions shown to establish North line of
Arbor Street and South line of alley as shown, on the
plat. Set 5/8" X 24" steel pins with plastic caps
stamped "DW EDWARDS-LS 741".

BASIS OF BEARINGS: R.S. 6665

DATE COMPLETED: July 29, 1986

SURVEY FOR: Darrel W. Edwards
2000 Brookhurst #27
Medford, Oregon 97504
Phone: 776-2313

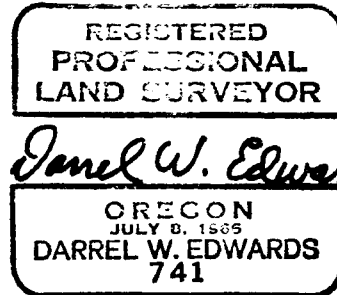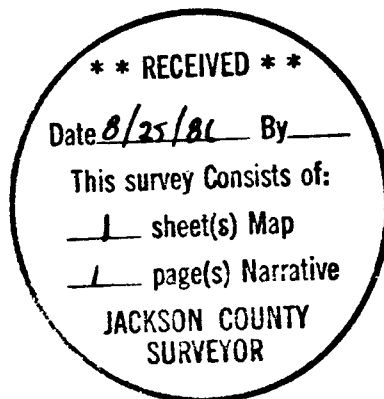

T 36-4W, Sec. 22BB, TL 2300