

SCALE 1" = 60'

Basis of Bearings: Solar Observation

LEGEND

- = Set 5/8" x 24" I. Pin (tagged R.L.S. 638)
- = Fd. 5/8" I. Pin w/ O.S.H.D. alum. cap (unless noted otherwise)

REGISTERED
PROFESSIONAL
LAND SURVEYOR
George Burrell
OREGON
JULY 10, 1964
GEORGE H. BURRELL
63

MAP OF SURVEY
Located in N.W. 1/4 Section 5, T37S, R1W
For: MEDFORD STATE BANK
By: George Burrell, R.L.S., 9/15/66

** RECEIVED **
- 1 Narrative
JACKSON COUNTY
SURVEYOR

SURVEY NO. 10686

SURVEY NARRATIVE TO COMPLY WITH O.R.S. 209.250

FOR: Medford State Bank
P.O. Box 4400
Medford, Oregon 97501

PURPOSE: To monument the boundaries of tax lot no. 601-37-1W-5 according to deed record.

PROCEDURE: The Meridian was established by Solar observation (L.H.A. method) using time from W.W.V. and Latitude and Longitude derived from O.S.H.D. State plane coordinates shown for the West 1/4 corner of section 5. Said lot boundaries were then established according to deed record distance and bearing from the West 1/4 corner of section 5. The relocated Easterly right of way of Crater Lake Highway was established from found monuments as shown on the accompanying map.


BY: George Burrell, R.L.S.
1379 Brookdale
Medford, Oregon 97504

Sept. 15, 1986

REGISTERED
PROFESSIONAL
LAND SURVEYOR

George Burrell

OREGON
JULY 10, 1984
GEORGE W. BURRELL
622

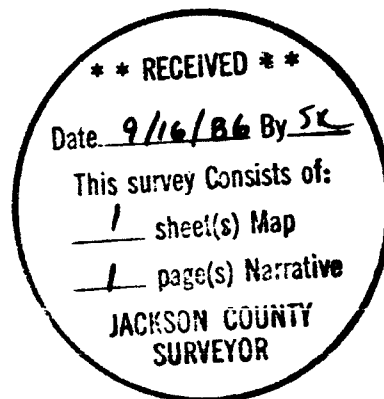

Tax Lot No. 601-37-1W-5