


21201

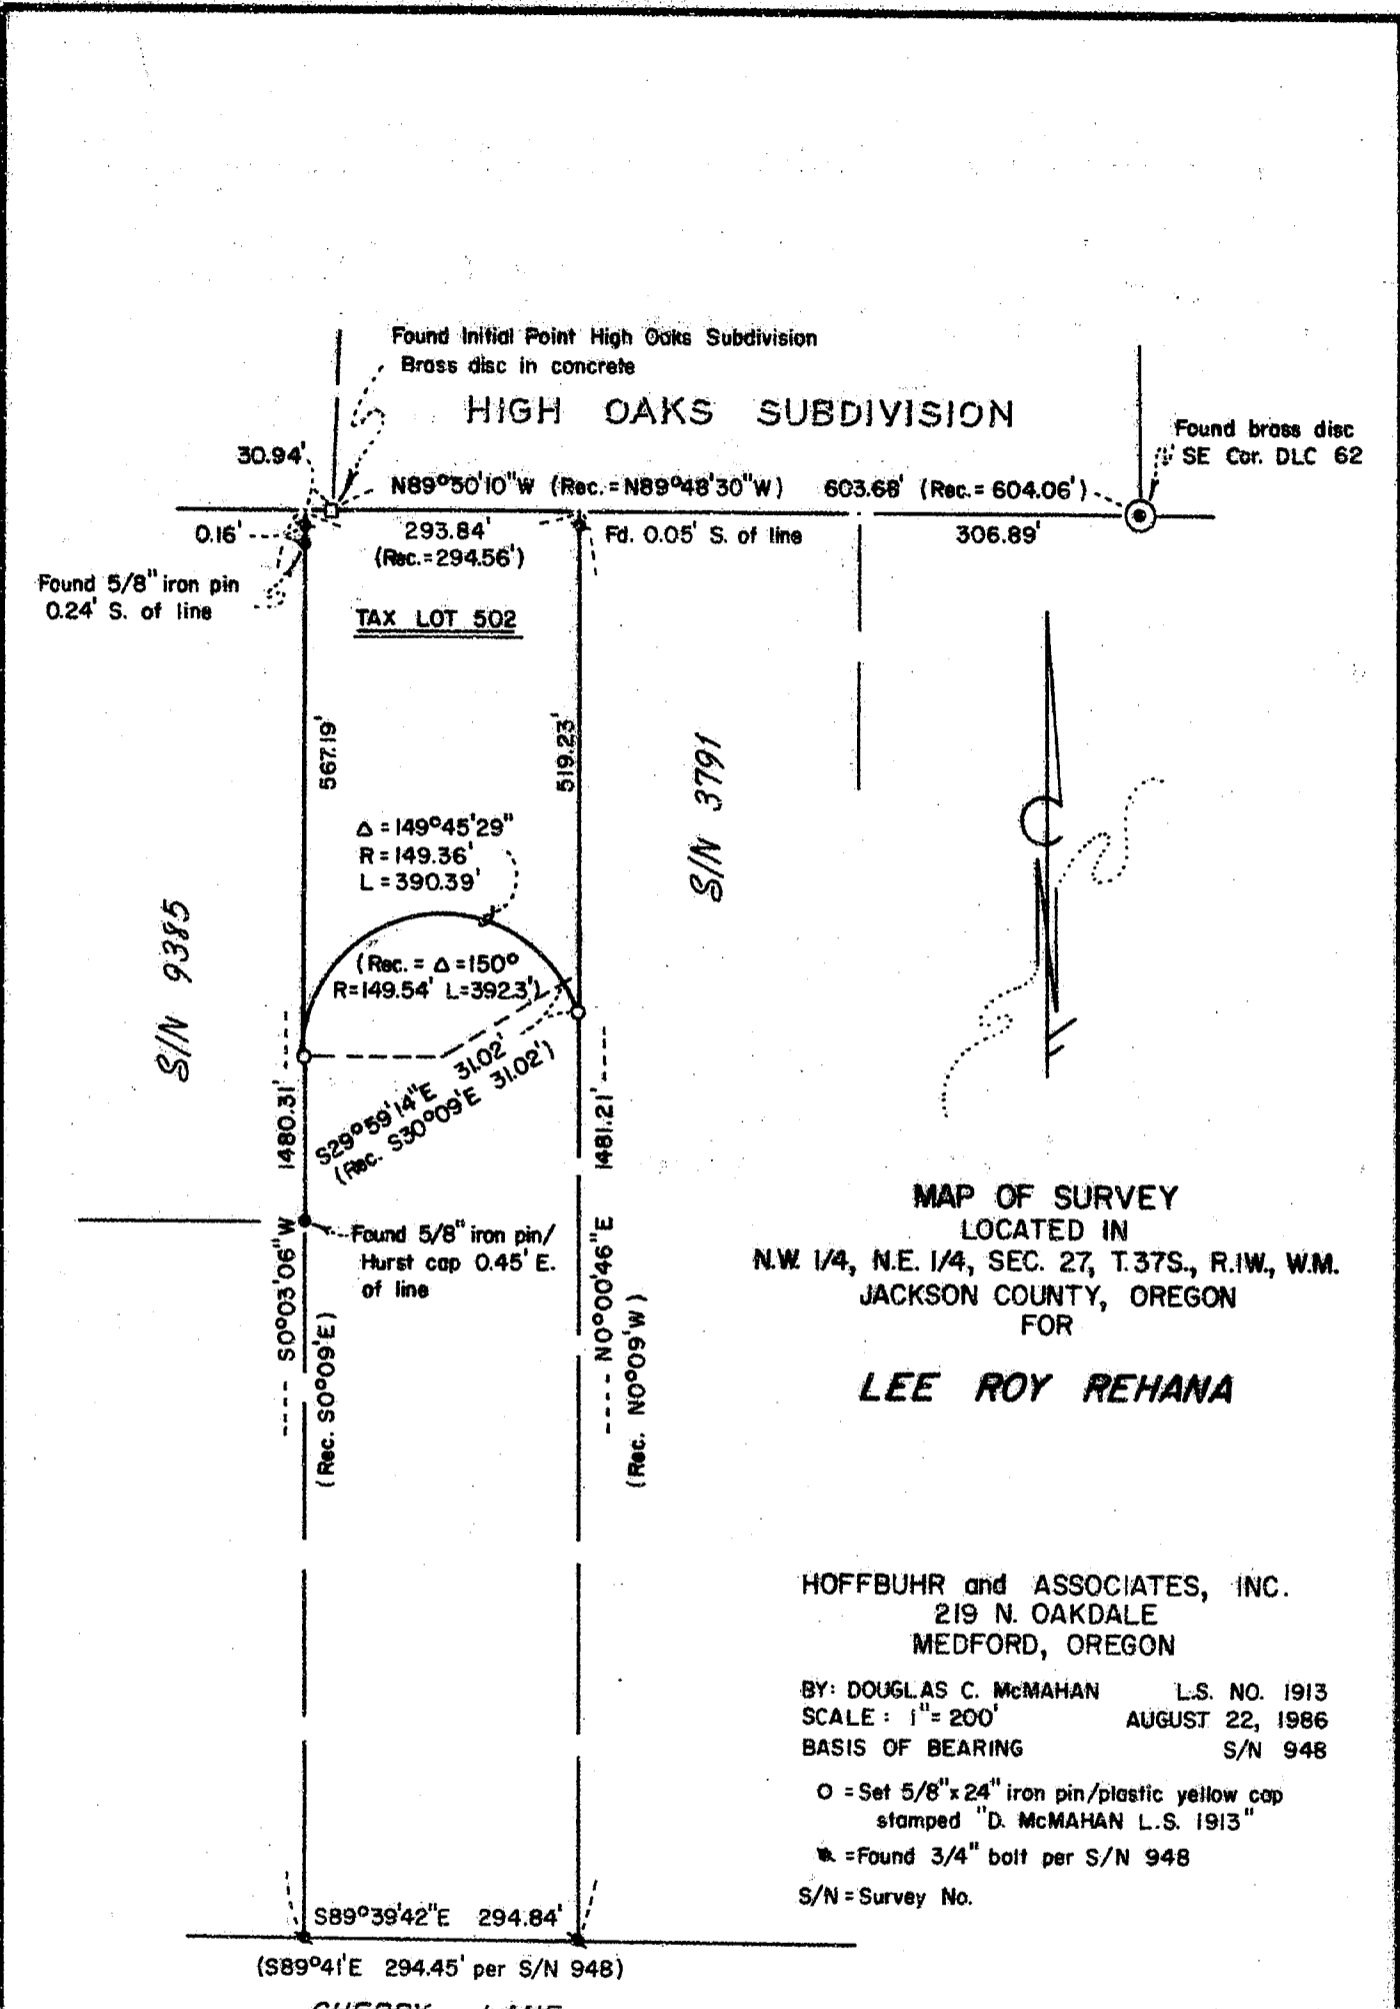

MAP OF SURVEY
 LOCATED IN
 N.W. 1/4, N.E. 1/4, SEC. 27, T.37S., R.1W., W.M.
 JACKSON COUNTY, OREGON
 FOR

LEE ROY REHANA

HOFFBUHR and ASSOCIATES, INC.
 219 N. OAKDALE
 MEDFORD, OREGON

BY: DOUGLAS C. McMAHAN L.S. NO. 1913
 SCALE: 1" = 200' AUGUST 22, 1986
 BASIS OF BEARING S/N 948

O = Set 5/8" x 24" iron pin/plastic yellow cap
 stamped "D. McMAHAN L.S. 1913"
 * = Found 3/4" bolt per S/N 948
 S/N = Survey No.

**** RECEIVED ****
 Date 11/4/86 By JK
 This survey consists of:
1 sheet(s) Map
1 page(s) Narrative
**JACKSON COUNTY
 SURVEYOR**

REGISTERED
**PROFESSIONAL
 LAND SURVEYOR**

Douglas C. McMahon

OREGON
DOUGLAS C. McMAHAN
 No. 1913

21201

SURVEY NO. 10717

SURVEY NARRATIVE TO COMPLY WITH PARAGRAPH 209.250
OREGON REVISED STATUTES

SURVEY FOR: Lee Roy Rehana
3655 Cherry Lane
Medford, Oregon 97504


LOCATION: Northwest one-quarter ($\frac{1}{4}$) of the
Northeast one-quarter ($\frac{1}{4}$) of Section
27, Township 37 South, Range 1 West,
Willamette Meridian, Jackson County,
Oregon

PURPOSE: To survey and monument the existing
Tax Lot 502 as shown on the attached
map of survey per client's request.


PROCEDURE: Utilizing the information from previous Survey's
No. 948, 3791, 9385 and the plat of High Oaks
Subdivision, I reviewed the legal descriptions
of Tax Lot 502 and adjoining tax lots to deter-
mine the boundaries of Tax Lot 502. I then
traversed through the found monumentation and
established the corners of Tax Lot 502 as
shown on the attached map of survey.


August 22, 1986

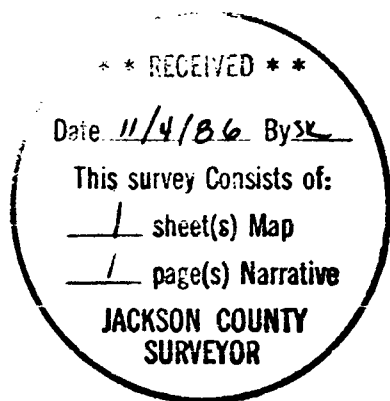

Douglas C. McMahan

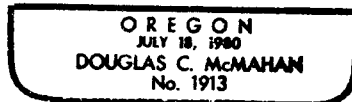

Douglas C. McMahan
Hoffbuhr & Associates, Inc.
219 North Oakdale
Medford, Oregon 97501

37S 1W SEC. 27/Tax Lot 502