


10721

CERTIFIED RECORD OF LAND CORNER MONUMENTATION

**History of original corner establishment:**

The original corner point for the closing corner for Sections 5 and 6, Township 36 South, Range 4 East, Willamette Meridian, Jackson County, Oregon, was established by Lincoln Wilkes under contract No. 86, dated July 11, 1922.

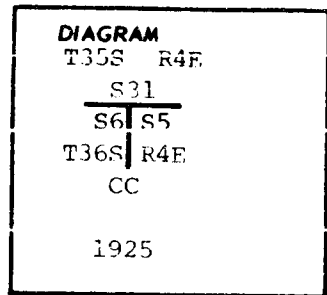

**Description of corner evidence found:**

Found a 2 1/2-inch diameter General Land Office monument marked as shown in diagram with a mound of stone to the south, and the following accessories:

A 17-inch diameter fir bears S.38°30'E., 27.1 feet distance, with a healed blaze at the base of the tree.

A dead and down rotted fir bears S.34°W., 17.0 feet distance to remains of fragmentary scribing. The original stump hole position could not be determined.

**Description of monument and accessories established to perpetuate the original location of this corner**

I stabilized the monument as needed and marked the following accessories:

A 10-inch diameter chinquapin bears S.69°30'W., 17.5 feet distance, scribed T36S R4E S6CC LS1071 BT.

October 17, 1986

HAROLD L. CENTER  
Registered Professional Land Surveyor  
Oregon Certificate No. 1071



Office of ..... County of .....

State of ....., I hereby certify that the within instrument was filed in this office  
for record on the ..... day of ....., 19....., at ..... o'clock .....m., (signed)

..... by .....

(COUNTY OFFICIAL) (DEPUTY)

Form R6-7100-57 (9/66)

