


CERTIFIED RECORD OF LAND CORNER MONUMENTATION

History of original corner establishment:

THIS TREE IS AN ORIGINAL LINE  
TREE BETWEEN SECTIONS 2 AND 35, T32S  
AND T33S, R2W, W.M.

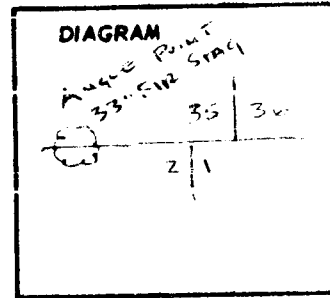

Description of corner evidence found:

FOUND A 33" FIR SNAG WITH OLD AXE WORK

Description of monument and accessories I established to perpetuate the original location of this corner

I MARKED,  
A 9" CEDAR WHICH BEARS S24°W 38.4' SCRIBED AP S2 BT  
A 7" FIR WHICH BEARS N67°W 9.9' SCRIBED AP S2 BT  
BOTH TREES HAVE L.S. WASHER #944 NAILED TO BT SCRIBE

DATE: OCT., 1986

REGISTERED  
PROFESSIONAL  
LAND SURVEYOR

*Lloyd R. Moffitt*  
OREGON  
JULY 17, 1970  
LOYD R. MOFFITT  
944

Office of Surveyor County of Jackson  
State of Oregon, I hereby certify that the within instrument was filed in this office  
for record on the 7<sup>th</sup> day of November, 1986.  
Richard A. M. Kelly by \_\_\_\_\_  
(COUNTY OFFICIAL) (DEPUTY)

**\*\* RECEIVED \*\***  
Date 11/7/86 By SK  
This survey consists of:  
0 sheet(s) Map  
1 page(s) Narrative  
JACKSON COUNTY  
SURVEYOR