


10726

CERTIFIED RECORD OF LAND CORNER MONUMENTATION

History of original corner establishment:

THIS CORNER WAS SET IN 1908 BY  
THE S.L.M.

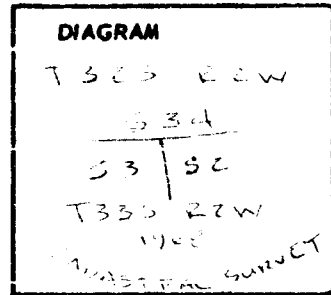

Description of corner evidence found:

FOUND BRASS CAP ON 2" IRON PIPE IN ROCK MOUND

Description of monument and accessories I established to perpetuate the original location of this corner

FOUND A 38" FIR WHICH BEARS S 69° W 30.4', SCAR VISIBLE.  
FOUND A FIR SMAQ WHICH BEARS S 30° E 38.9', SCRIBE VISIBLE.  
I SCRIBED A 16" YEW WOOD TREE WHICH BEARS S 27° E 38.6',  
MARKED T 335 R 2W S 2 C C BT, NALLED LS WASHER NO. 944  
TO BT SCRIBE.

DATE: OCT., 1986



Office of Surveyor County of Jackson  
State of Oregon, I hereby certify that the within instrument was filed in this office  
for record on the 7<sup>th</sup> day of November, 1986  
Edward L. McEnty by \_\_\_\_\_  
(COUNTY OFFICIAL) (DEPUTY)

