


SURVEY IN SEC. 1 T. 38 S. R. 2 W. W.M
FOR
ROB'T DAUN

BY L.P. LOVEJOY
 MEDFORD, OREG.
 MARCH 1957

SCALE 1" = 100'
 ○ = 1/2" PIPE SET

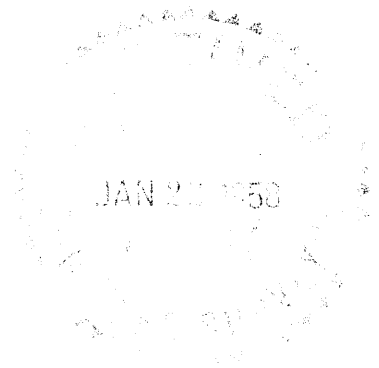

REGISTRATION
OREGON
LAND SURVEYOR
Leland P. Lovejoy
 NOVEMBER 18, 1948
LELAND P. LOVEJOY
 262

Survey Narrative to Comply With
Section 87-330 of 1947 Oregon State Laws

Survey for: Robert Daun
Kings Highway
Medford, Oregon

Purpose of Survey: Run out property boundaries

Survey Location: Section 1, Township 38 South, Range 2
West, Willamette Meridian, Jackson
County, Oregon.

Survey Procedure: Found corners as shown on map. Set 1/2"
galvanized iron pipe as indicated on map.

Leland P. Lovejoy
Registered Land Surveyor
Work completed April 8, 1957

