


TL 2409
20.54 Acres

TL 2418
10.58 Acres

DETAIL
Scale: 1" = 200'

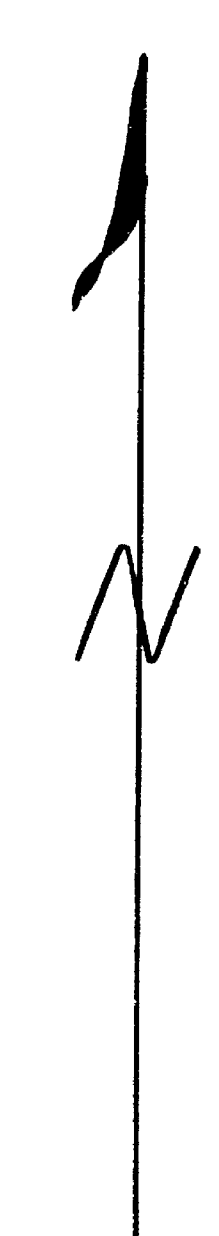

BASIS of BEARINGS: R.S. 9969

**** RECEIVED ****
Date 11/13/86 By SK
This survey consists of:
JACKSON COUNTY
SURVEYOR

DARREL W. EDWARDS
JACKSON COUNTY
SURVEYOR

SURVEY FOR: L. EUGENE and LINDA HOWARD		
SCALE: 1" = 600'	<input checked="" type="checkbox"/> MONUMENTS FOUND	DRAWN BY D.W.E.
DATE: Sept. 8 Oct., 1986	<input checked="" type="checkbox"/> SET 5/8" X 24" STEEL PIN	REVISED
LOCATION: SE 1/4 of SECTION 20, T. 36 S., R. 3 W., W.M. JACKSON COUNTY, OREGON		
SURVEY BY: DARREL W. EDWARDS 2000 BROOKHURST # 27 MEDFORD, OREGON 97504	DRAWING NUMBER	

93-32050 **Edwards Surveying & Land Planning Inc.**

506

6.00 per'

2:50

DARREL W. EDWARDS
OREGON REG. 741
ARIZONA REG. 9746



DAVID A. EDWARDS
OREGON REG. 2339

REGISTERED LAND SURVEYORS
823 WEST 8TH ST.
MEDFORD, OREGON 97501
(503) 776-2313 • (503) 471-7059

10730

AFFIDAVIT OF CORRECTION

This affidavit of correction is in regard to a survey for L. Eugene and Linda Howard, map of survey filed as County Survey Number 10730.

Be it hereby noted that the distances along the South lines of the Southwest 1/4 of the Southeast 1/4 and the Southeast 1/4 of the Southeast 1/4 of Section 20 shown as 1315.04 feet should be corrected to read 1315.54 feet.

Date: Sept. 22, 1993

Darrel W. Edwards

Darrel W. Edwards-R.P.L.S. 741

Jackson County, Oregon
Recorded
OFFICIAL RECORDS

2:50 SEP 24 1993 P.M.

KATHLEEN S. BECKETT
CLERK and RECORDER

Mary Ann [Signature] Deputy

REGISTERED
PROFESSIONAL
LAND SURVEYOR

Darrel W. Edwards

OREGON
JULY 9, 1966
DARREL W. EDWARDS
741

Expires 12/31/93

CERTIFICATION

I, Verlyn Thomas, Jackson County Surveyor, hereby certify that I have examined this Affidavit of Correction, and that the changes are permitted in accordance with Oregon Revised Statute 209.255.

Verlyn Thomas
Verlyn Thomas-Jackson County Surveyor

SURVEY NO. **10730**

SURVEY NARRATIVE TO COMPLY WITH PARAGRAPH 209.250, OREGON REVISED STATUTES.

SURVEY FOR: L. Eugene & Linda Howard
2048 Lampman Road
Gold Hill, Oregon 97525

LOCATION: Southeast 1/4 of Section 20, Township 36 South,
Range 3 West of the Willamette Meridian, Jackson
County, Oregon.


PURPOSE: To survey the perimeters and set the property
corners of two tax lots per Jackson County
Deed Records.

PROCEDURE: Traversed between corners common to Section
20 as shown on accompanying plat. Made survey
ties to 5/8" iron rods set in R.S. 4227 and
R.S. 5500 marking 60 foot access strip of land
to parcels surveyed. Calculated position of
property corners. Ran closed traverse around
both parcels and set property corners as shown
on the accompanying plat.

BASIS OF HEARINGS: R.S. 9969

DATE COMPLETED: October 31, 1986

SURVEY BY: Darrel W. Edwards
2000 Brookhurst #27
Medford, Oregon 97504
Phone: 776-2313

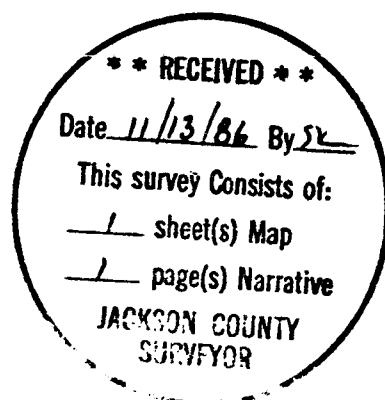

Darrel W. Edwards

