

Basis of Bearings: RS 4166

RECEIVED  
Date 11/13/86 By JK  
This survey consists of:  
1 sheet(s) Map  
1 spec(s) Narrative  
JACKSON COUNTY  
SURVEYOR

REGISTERED  
PROFESSIONAL  
LAND SURVEYOR  
Darrel W. Edwards  
OREGON  
JULY 6, 1983  
DARREL W. EDWARDS  
741

SURVEY FOR: ADAMS & BUNN		
SCALE: 1" = 200'	<input type="checkbox"/> Monument Found as Noted	DRAWN BY: D.W.E.
DATE: Sept. 30, 1986	<input checked="" type="checkbox"/> Br. Cap in Concrete Monument	REVISED
	<input type="checkbox"/> Set 5/8" x 24" Steel Pin	
LOCATION: EAGLE HEIGHTS FRUIT FARMS in SE 1/4 of Section 2, T. 36 S., R. 1 W.W.M., Jackson County, Oregon.		
Darrel W. Edwards SURVEY BY: 2000 Brookhurst # 27 Ph: 776-2313 Medford, Oregon 97504		DRAWING NUMBER

SURVEY NO. **10733**

SURVEY NARRATIVE TO COMPLY WITH PARAGRAPH 209.250, OREGON REVISED STATUTES.

SURVEY FOR: Gregg Adams & Dan Bunn  
2399 Springbrook Road  
Medford, Oregon 97504

LOCATION: Fraction of Eagle Heights Fruit Farms in  
Southeast 1/4 of Section 2, Township 36  
South, Range 1 West of the Willamette Mer-  
idian in Jackson County, Oregon.


PURPOSE: Survey and monument original Lots of Eagle  
Heights Fruit Farms as shown on the accomp-  
anying plat.

PROCEDURE: Traversed between found monuments as shown on  
the accompanying plat. Used Brass cap monuments  
set in concrete by U.S. Government for perimeter  
control of subject lots. Relocated Stevens  
Road established by Jackson County Department  
of Public Works. Set Lot corners as shown on  
the accompanying plat. Set 5/8" X 2 1/2" steel  
pins with yellow caps stamped "DW EDWARDS-  
PLS 741".

BASIS OF BEARINGS: R.S. 4166

DATE COMPLETED: September 30, 1986

SURVEY BY: Darrel W. Edwards  
2000 Brookhurst #27  
Medford, Oregon 97504  
Phone- 776-2313

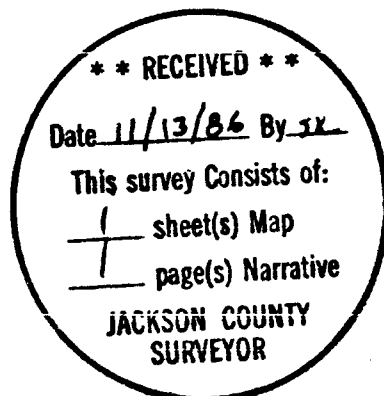

REGISTERED  
PROFESSIONAL  
LAND SURVEYOR

*Darrel W. Edwards*  
OREGON  
JULY 8, 1966  
DARREL W. EDWARDS  
741

T. 36, 1W., S. 2  
T.L. No. 2900, 3000, 3100, 3300,  
3400.