

107401

1074

SURVEY IN SEC. 8 T.37S.R2W.W.M.
FOR
R. COOK

BY L.P. LOVEJOY
MEDFORD, OREG.
MARCH 1957


SCALE 1" = 100'
○ = 3/4" PIPES
○ = 1" PIPES FD.



REGISTERED
OREGON
LAND SURVEYOR

Leland P. Lovejoy

NOVEMBER 18, 1948
LELAND P. LOVEJOY
2-8-2

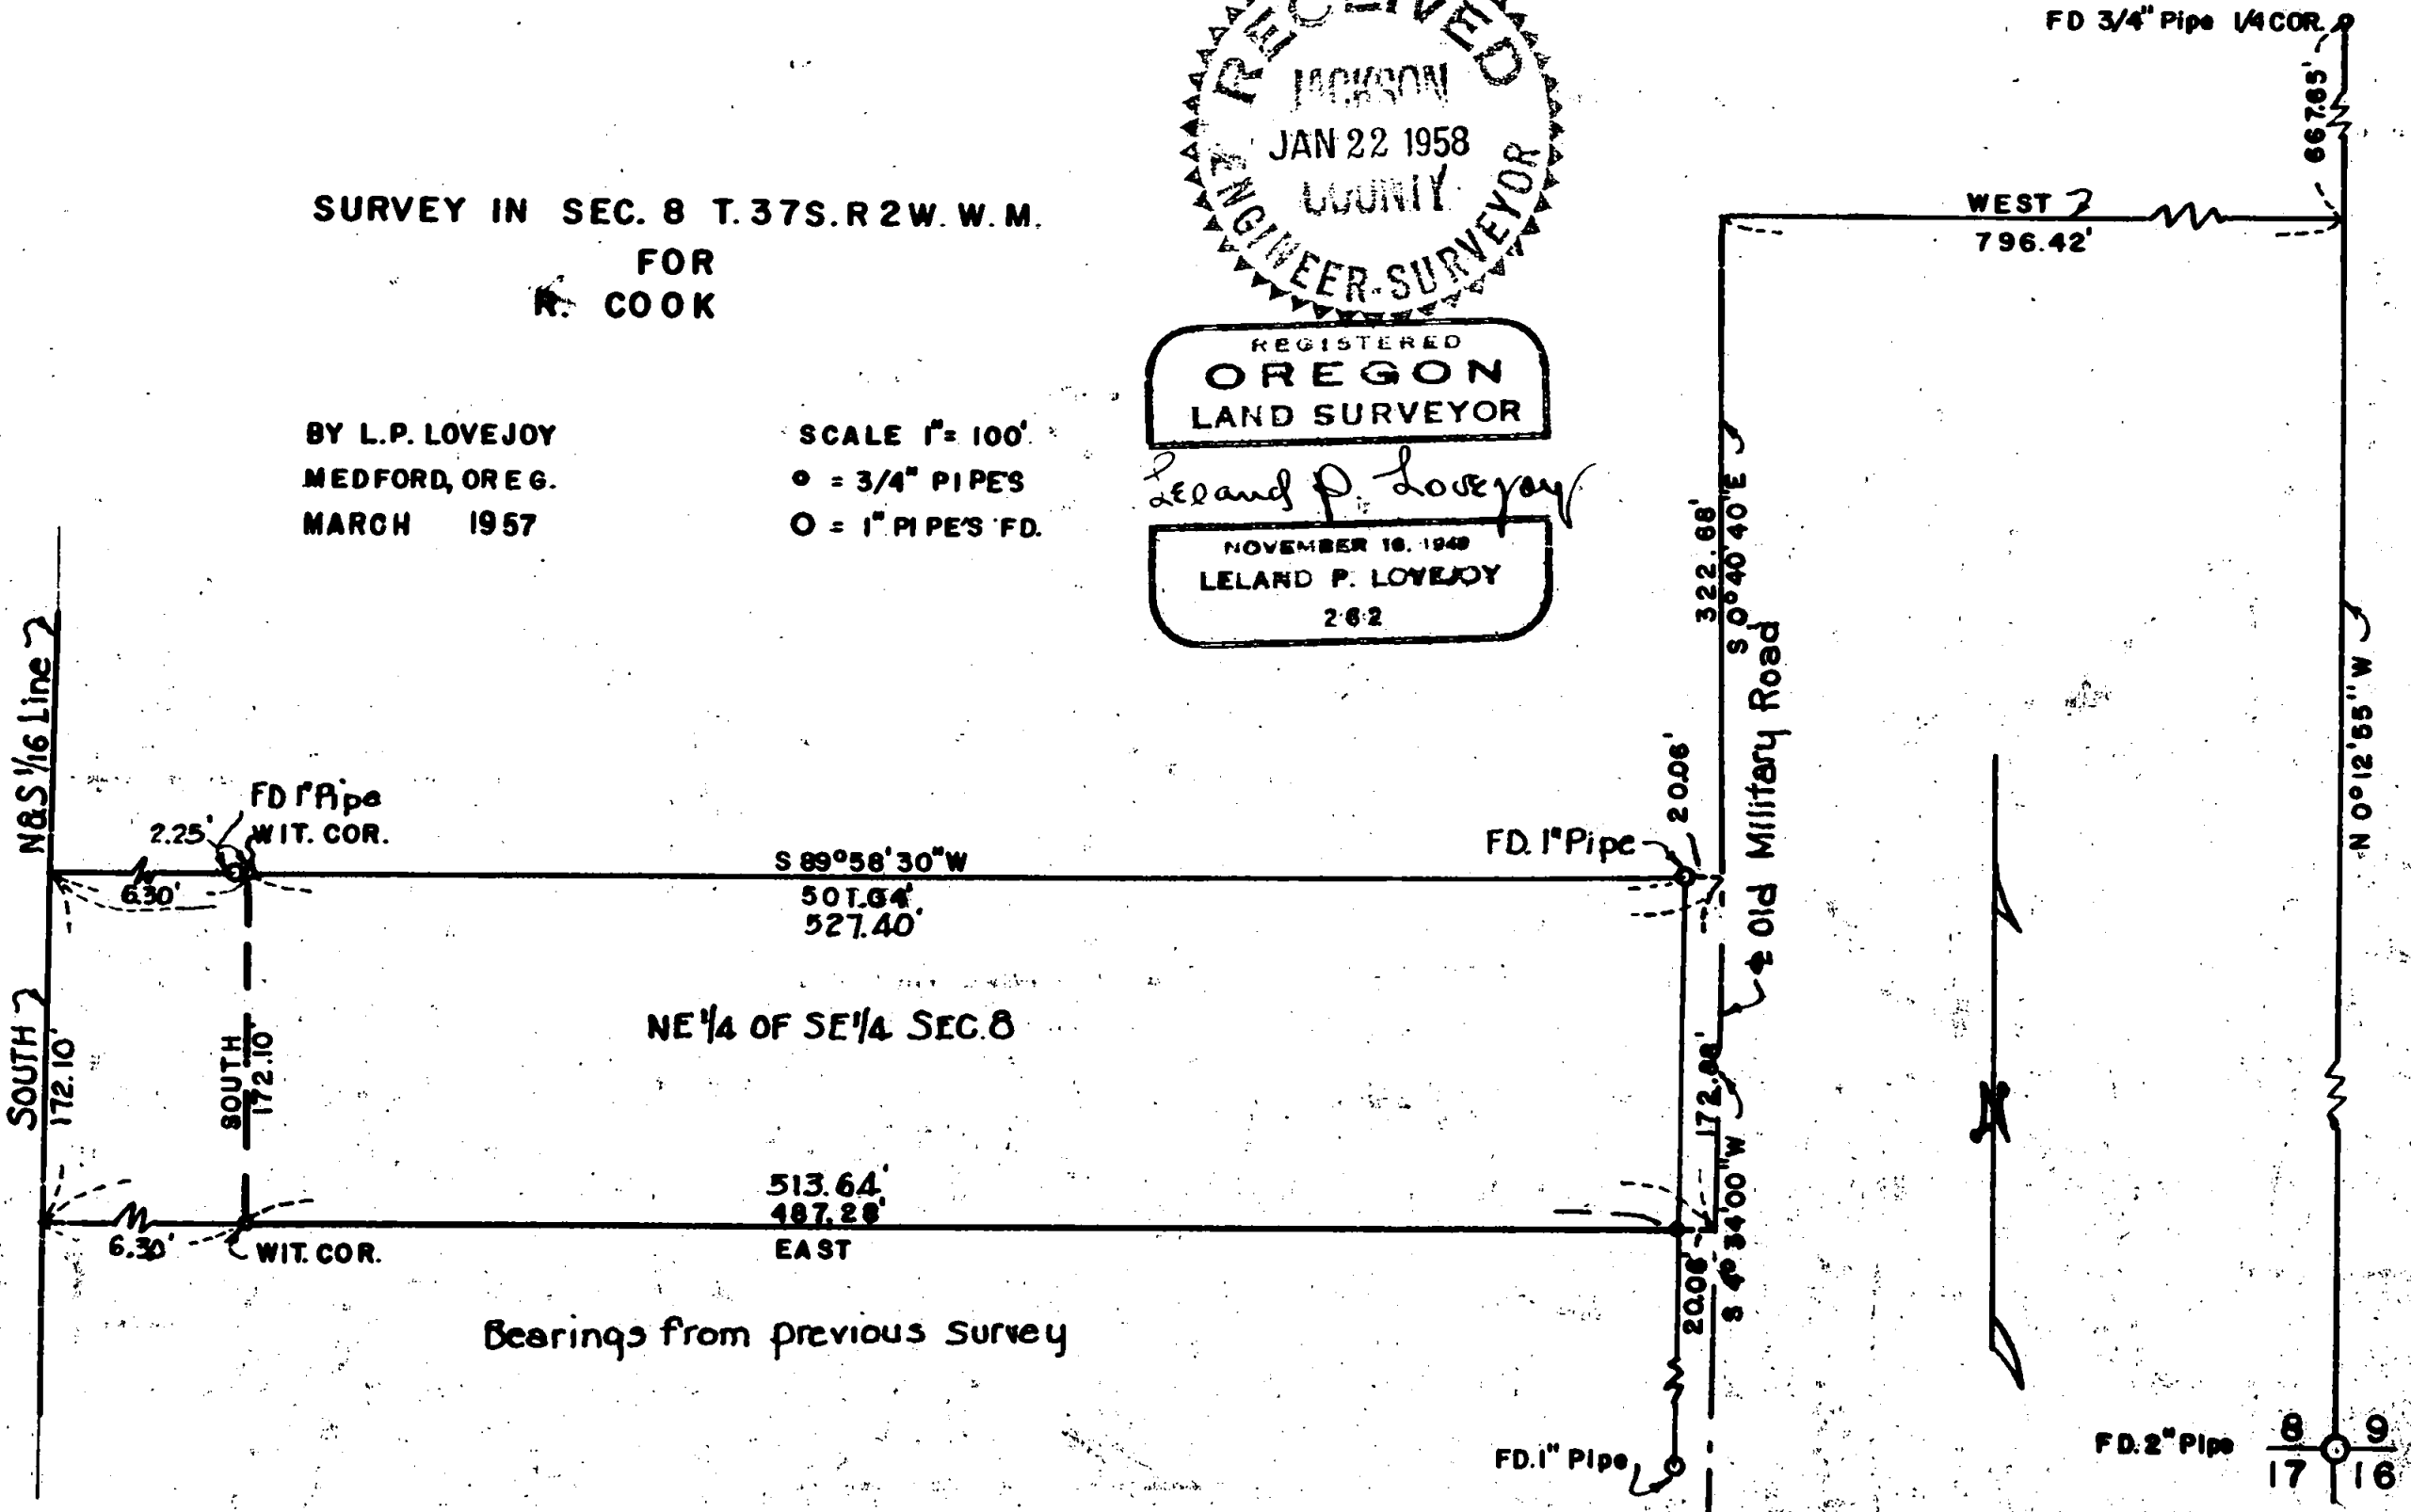

Bearings from previous survey

1074

Survey Narrative to Company With
Section 87-330 of 1947 Oregon State Laws


Survey for: R. Cook
Old Military Road
Medford, Oregon

Purpose of Survey: Run out property boundaries

Survey Location: Section 8, Township 37 South, Range 2
West, Willamette Meridian, Jackson
County, Oregon.

Survey Procedure: Found corners as shown on map. Set 3/4"
galvanized iron pipes as indicated on map.

Leland P. Lovejoy
Registered Land Surveyor
Medford, Oregon
Work completed April 10, 1957

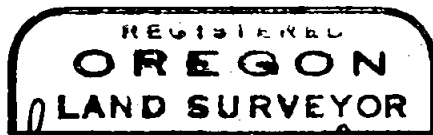

Leland P. Lovejoy

