


NE 1/4 SW 1/4 S 7 T 35S R 2E W.M.

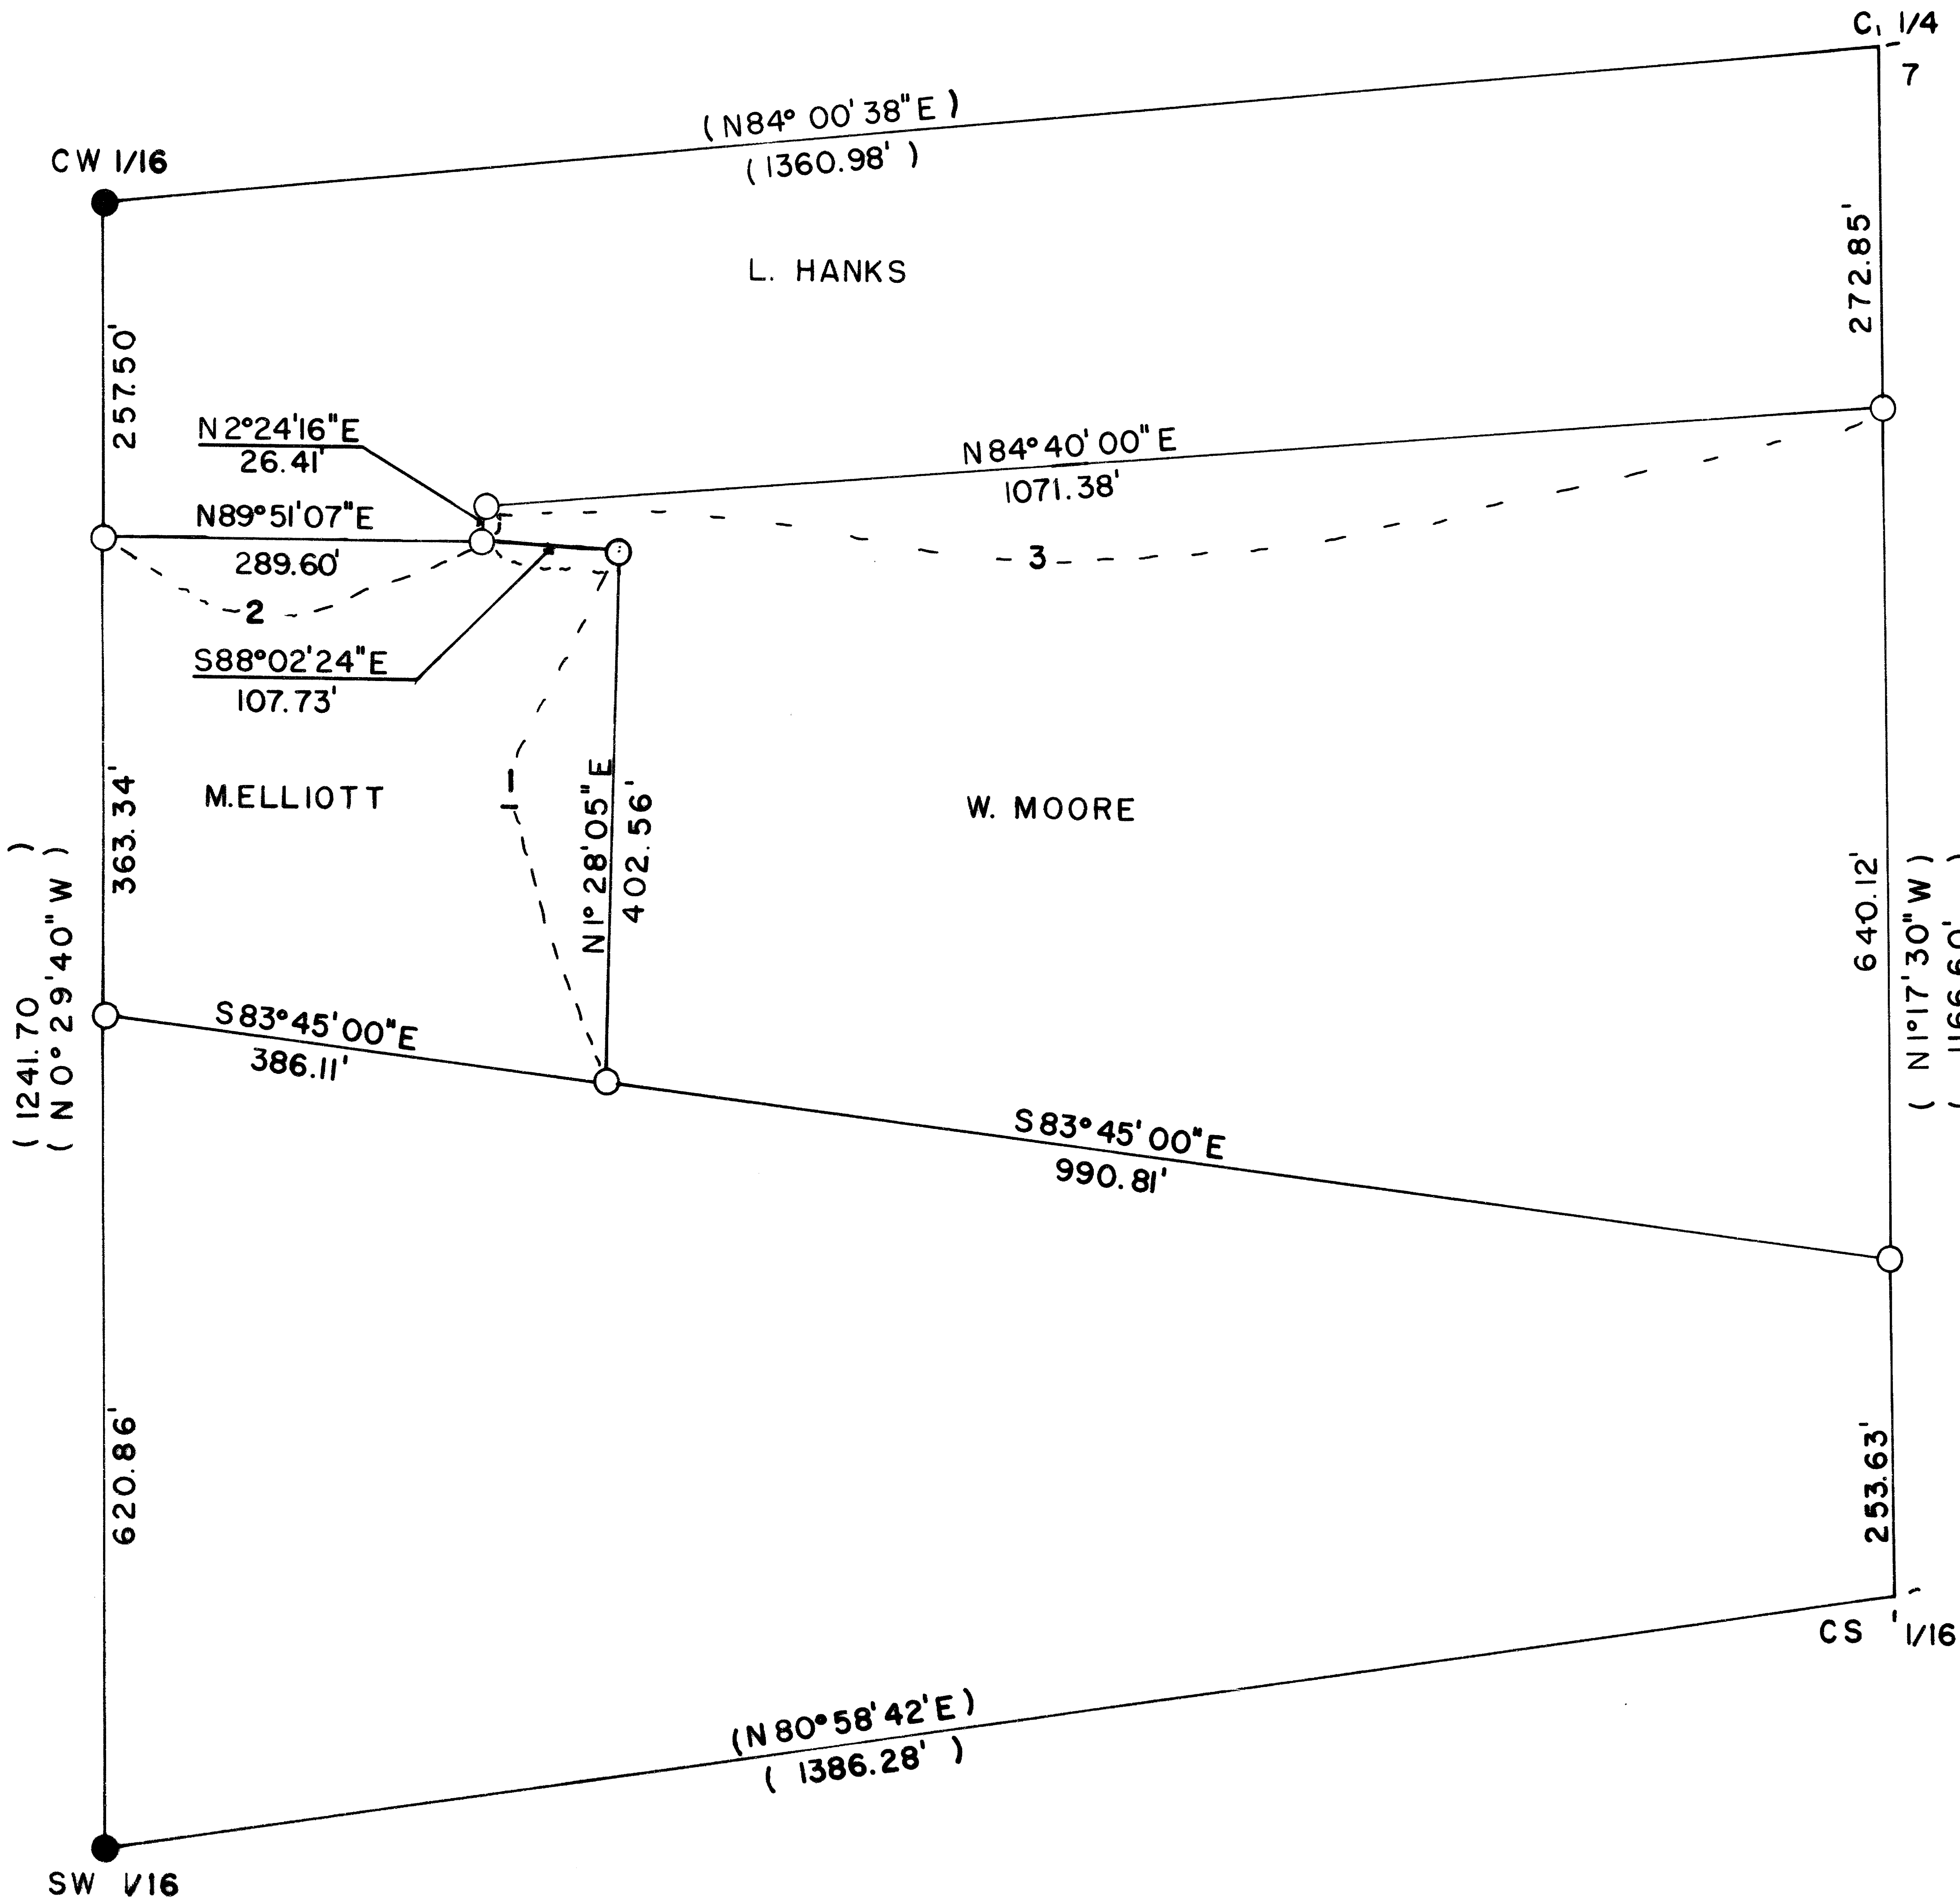

CERTIFICATE OF SURVEY

I, ARTHUR R. RAMBO, REGISTRATION No. 1086 REGISTERED PROFESSIONAL LAND SURVEYOR STATE OF OREGON, HEREBY CERTIFY THAT THIS MAP CORRECTLY REPRESENTS A SURVEY MADE BY ME OR UNDER MY DIRECTION IN CONFORMANCE WITH THE LAWS OF THE STATE OF OREGON.

REGISTERED PROFESSIONAL LAND SURVEYOR

*Arthur R. Rambo*

OREGON  
MAY 21, 1996  
ARTHUR R. RAMBO  
No. 1086

LEGEND

- FOUND MONUMENT SET SURVEY No. 10500
- SET 5/8" BY 30" REBAR WITH 1/2" ALUM. CAP ( SURVEY No. 10500 )

BOUNDRY LINE AGREEMENT

- 1 W. MOORE AND M. ELLIOTT
- 2 M. ELLIOTT AND L. HANKS
- 3 W. MOORE AND L. HANKS

BASIS OF BEARING


SURVEY No. 10500

SCALE

1" = 100'

DATE

NOVEMBER 17, 1986

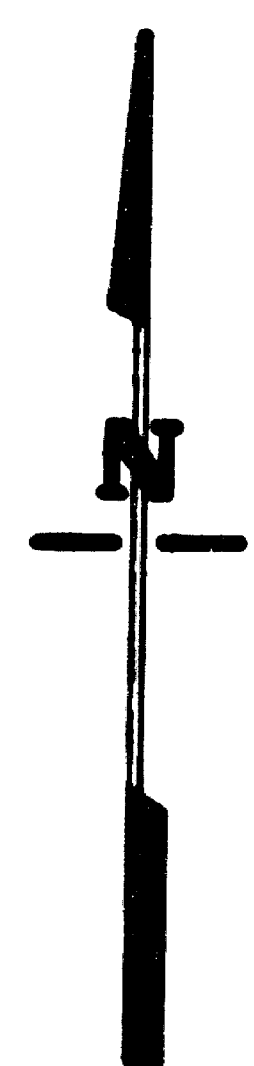

\*\*\* RECEIVED \*\*\*  
Date 12/2/86 By SK  
This survey consists of  
1 sheet(s) map  
1 page(s) Narrative  
SURVEYOR

SURVEY NARRATIVE TO COMPLY WITH O.R.S. 209.250

Location: Northeast quarter of Southwest quarter of Section 7,  
Township 35 South, Range 2 East, Willamette Meridian,  
Jackson County, Oregon.

Survey for: Wilford L. Moore Mark S. Elliott  
2150 Obenchain Rd. 3425 Obenchain Rd.  
Butte Falls, Oregon 97522 Butte Falls, Oregon 97522

Survey by: Arthur R. Rambo PLS 1086  
735 Vista Park Drive  
Eagle Point, Oregon 97524



Date: November 14, 1986

Basis of Bearing: Survey #10,500

Purpose: To set corners of property for Wilford L. Moore (DR 76-21179)  
and Mark S. Elliott (DR 84-11974). To set corners and  
write descriptions (forthcoming) for Boundry Line  
Agreement's mutually agreed upon by Wilford L. Moore,  
Mark S. Elliott, and Loyd M. Hanks.

Procedure: A subdivision of the Southwest quarter of said Section 7  
was completed on Survey #10,500. I used this subdivision  
to calculate the corner points for deed record 76-21179  
and 84-11974. I used monuments set on Survey #10,500  
to survey location of property from said deed records.  
There was question as to exact location of boundry lines  
from deed records as to fence lines found. The said  
three adjoining property owners mutually agreed upon  
property corners. I set monuments in these locations as  
shown on the plat to accompany this narrative.

Tax Lot #35-2E-900  
#35-2E-1000

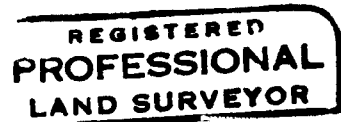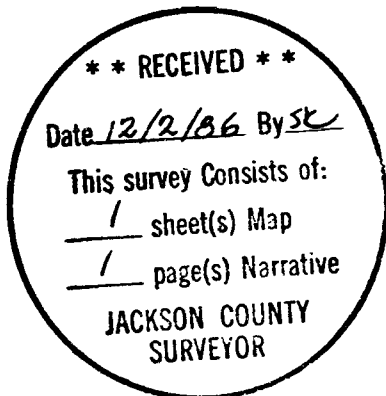

*Arthur R. Rambo*

