

92-29275

5.00
6.00 Surv
FEE
8:51

10745

AFFIDAVIT OF CORRECTION

I, Herbert A. Farber, a registered Professional Land Surveyor in the State of Oregon, having the survey records of Kurt C. Weaver who prepared a Map of Survey, County Surveyor's File No. 10745, for Richard Offenbacher, acknowledge the following drafting omissions in said Survey; The parcel west of the dashed line is as per Instrument No. 92-29273 of the Official Records of Jackson County, Oregon and the parcel east of said dashed line is as per Instrument No. 92-29274 of said records.

Prepared by: Farber Surveying
Farber and Sons, Inc.
908 East Jackson Street
Medford, Oregon 97504

Date: September 25, 1992

REGISTERED
PROFESSIONAL
LAND SURVEYOR



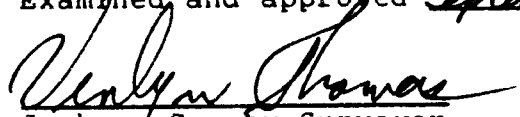
OREGON
JULY 26, 1985
HERBERT A. FARBER
2189

Subscribed and sworn to before me this 25th day of September

1992. Lyndall M. Sellens
Notary Public

OFFICIAL SEAL
LYNDALL M. SELLENS
NOTARY PUBLIC - OREGON
COMMISSION NO. 014591
MY COMMISSION EXPIRES APR 12, 1996

Examined and approved September 28, 1992


Jackson County Surveyor

Jackson County, Oregon
Recorded
OFFICIAL RECORDS

8:51 SEP 28 1992 AM

KATHLEEN S. BECKETT
CLERK and RECORDER



Posted 9/28/92
V.T. C.S.

Survey No. 10745

SURVEY NARRATIVE TO COMPLY WITH O.R.S. 209.250.

Survey for: Mr. Richard Offenbacher
12223 Highway 238
Jacksonville, Oregon 97530

Location: Located in the northeast quarter of Section 25 and in
Donation Land Claim No. 37, Township 38 South, Range 4
West of the Willamette Meridian, Jackson County, Oregon.

Purpose: To monument a Lot Line Adjustment as shown on the accom-
panying map (Jackson County Planning file no. 86-69-LLA).
Also to monument a proposed adjustment line.

Procedure: Utilizing found monumentation from filed survey no. 4294
I set the monuments shown on the accompanying map.

Three of the monuments were in concrete, which was not
called for on the original map. This concrete was placed
by the property owner, and probably accounts for the dis-
crepancy between measured and record. Because the monu-
ments were found in positions acceptable to that of record
they were used for the basis of bearing and control for
this survey. The record tie to the northwest corner of
DLC no 37 was used as shown.

Surveyed by: Kurt C. Weaver
616 China Gulch Road
Jacksonville, Oregon 97530

Date: November 4, 1986

REGISTERED
PROFESSIONAL
LAND SURVEYOR

Kurt C. Weaver
OREGON
JULY 14, 1978
KURT C. WEAVER
1679

