

10780



SURVEY NO. 4338

HAMILTON

ROAD

SURVEY NO. 10283

N 89°04'00"E 1098.03'

100.00'

S 00°12'36"W 594.50'

EAST 21.80'

FD. B.C. MARKING THE N.E. COR. D.L.C. NO. 41

SOUTH 26.59'

FD. SANDSTONE WITH "X"

S 89°04'00"W 713.68'

100.00'

LEGEND:

- = FOUND 1" IRON PIPE UNLESS OTHERWISE NOTED.
- ⊙ = FOUND 5/8" IRON PIN.
- = SET 5/8" IRON PIN WITH PLASTIC CAP STAMPED MOFFIT PLS 944.

BASIS OF BEARINGS:

SURVEY NO. 4338.

REGISTERED PROFESSIONAL LAND SURVEYOR

Loyd R. Moffit

OREGON
JULY 17, 1970
LOYD R. MOFFIT
944

** RECEIVED **

Date 1/21/87 By JY

This survey consists of:

1 sheet(s) Map

1 page(s) Narrative

JACKSON COUNTY
SURVEYOR

PLAT OF SURVEY

FOR

ELDA CRANE

BEING A PORTION OF THE S.E. 1/4 OF SEC.

33, T.38 S., R. 3 W., W.M.

JACKSON CO.

SCALE: 1"=100'

OREGON

DATE: JAN., 1987

PREPARED BY: FRIAR-MOFFIT AND ASSOC.

MEDFORD, OREGON

10780

85-101

38 3W 33

Survey No. 10780

Survey Narrative to comply with O.R.S. 209.250


Survey For: Eida Crane
900 Hamilton Road
Jacksonville, OR 97530

Location: In the Southeast one-quarter of Section 33,
Township 38 South, Range 3 West, Willamette
Meridian, Jackson County, Oregon.

Purpose: To adjust the East line of the parcel as
shown on Survey No. 10283. This new line
reflects what was submitted to the Jackson
County Planning Department. See 85-7-LLA.

Procedure: Found pins shown on Survey No. 10283.
Extended Northerly property line East
100.00 feet and set new corner.

Date: January, 1987

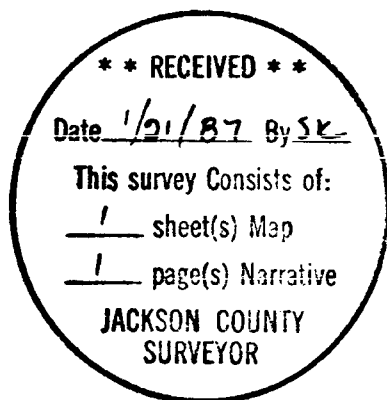

Loyd R. Moffit
Friar-Moffit & Assoc.
717 W. 10th St.
Medford, OR 97501

T38S, R3W, Sec. 33
T.L. 900

