

SEC. COR.
Fd. 2 1/2" br. disc flush with pvt.



SCALE 1"=200'

Basis of Bearings Solar Observation
(at S.E. Cor. Sec. 1)

o = Set 5/8" x 24" I. Pin (tagged R.L.S 636)

** RECEIVED **
 Date 1/30/87 By SK
 This survey Consists of:
1 sheet(s) Map
1 page(s) Narrative
 JACKSON COUNTY
 SURVEYOR

REGISTERED
**PROFESSIONAL
 LAND SURVEYOR**
George Burrell
 OREGON
 JULY 10, 1984
 GEORGE R. BURRELL
 636

MAP OF SURVEY
 Located in S.W. 1/4 Sec. 1, T36S, R1W
 For: **ROBERT COLE**
 By: **George Burrell, R.L.S. 12/29/86**



SURVEY NARRATIVE TO COMPLY WITH O.R.S. 209.250

FOR: Robert Cole
1918 Stevens Road
Eagle Point, Oregon

PURPOSE: To monument the corners and boundary lines of the tract described as an exception in Document No. 72-05360 of the Official Records of Jackson County, Oregon.

PROCEDURE: The section boundary was determined from the found section corners as shown on the accompanying map. The East, West and North boundaries of said tract were monumented according to deed record.

BY: George Burrell, R.F.L.S.
1379 Brookdale
Medford, Oregon 97504
Dec. 29, 1986

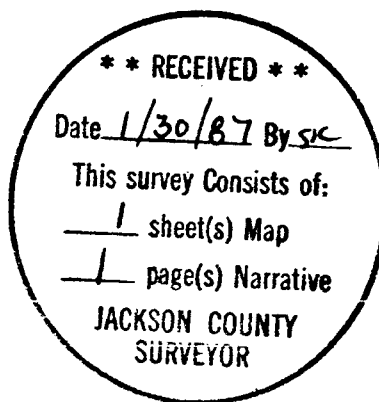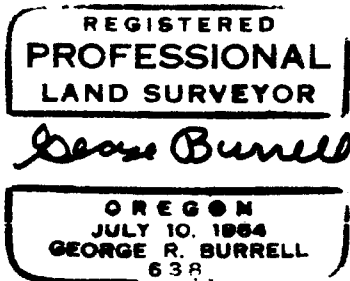

Tax Lot No. 2700-36-1W-1