


86201

SURVEY FOR:  
PACIFIC NORTHWEST BELL TELEPHONE  
R/W REF. NO. 86330015

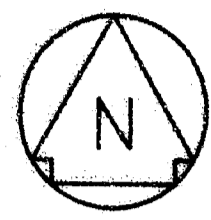

1" = 50'

SURVEYED BY:  
MARQUSS & ASSOCIATES, INC.  
MEDFORD, OREGON

LOCATION:  
SOUTHEAST QUARTER, SECTION 8,  
T. 37 S., R. 1 W., W.M.  
JACKSON COUNTY, OREGON

FEBRUARY 12, 1987

FOUND 5/8" I. PIN

TAX LOT 3801  
MAP 37 1W 8

RS 2171  
RS 601

BASIS OF BEARINGS S00°15'20"E PER RS 2171  
337.46' (RECORD 337.41')

● SET 5/8" x 24" REBAR WITH YELLOW PLASTIC CAP MARKED "MARQUSS & ASSOC." AT THE THREE EASEMENT CORNERS

○ FOUND 5/8" I. PIN  
0.35'E & 0.4'N

N00°15'20"W 15.00'

S89°54'E 10.00'

FOUND 5/8" REBAR TAGGED "BOYDEN RLS 281"

RS 9636

S00°15'20"E

60.00'  
N89°54'W

N89°54'W 10.00'

60.00'

DELTA WATERS ROAD

8 9  
17 16

SECTION CORNER

REGISTERED  
PROFESSIONAL  
LAND SURVEYOR

*Robert Joseph Milts*

OREGON  
SEPTEMBER 23, 1977  
ROBERT JOSEPH MILTS  
No. 1270

\*\* RECEIVED \*\*  
Date 2/13/87 By SK  
This survey consists of  
1 sheet(s) Map  
1 page(s) Narrative  
JACKSON COUNTY  
SURVEYOR

86201

1-3104

37 1W 8

SURVEY NARRATIVE TO COMPLY WITH PARAGRAPH 209.250  
OREGON REVISED STATUTES


SURVEY FOR: Pacific Northwest Bell Telephone Company  
132 West 4th Street  
P. O. Box 730  
Medford, Oregon 97501

LOCATION: Tax Lot 3801, Map 37 1W 8  
Lying within the Southeast Quarter of Section 8,  
Township 37 South, Range 1 West, Willamette Meridian,  
Jackson County, Oregon. Near SE Corner of Section 8.

PURPOSE: To monument an easement for PNB for underground  
communication lines and above ground cabinets.

PROCEDURE: We have searched for the monuments shown on RS2171. The  
found monument at the southeast corner of Tax Lot 3801 is not the  
original monument. It has been reset by Mark Boyden for a survey  
currently in progress, and not yet recorded. The 1" iron pipe shown  
as found on RS2171 and being 60 feet north of the Section corner  
common to Sections 8, 9, 15 and 17 is missing. This apparently is  
the same point as the Initial Point of the Table Rock View Estates  
Unit No. 1 (RS9636), which has also been destroyed. We have  
calculated the position of the missing monument from ties to the  
Section corner and the centerline monuments on Milhoan Drive as shown  
on RS9636. From this we have determined that the monument at the  
southwest corner of Tax Lot 3801 is in the correct position, and have  
therefore accepted it. Using the monumented east line, we then used  
the record bearings for the parcel to monument the easement  
description as furnished by PNB

February 12, 1987

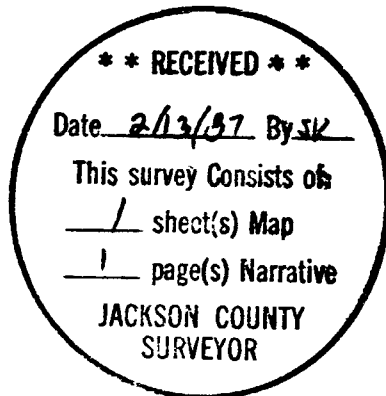

MARQUESS & ASSOCIATES, INC.  
1120 East Jackson Street  
P. O. Box 490  
Medford, Oregon 97501  
*Robert Joseph Milts*  
Robert Joseph Milts  
Professional Land Surveyor