


CERTIFIED RECORD OF LAND CORNER MONUMENTATION

History of original corner establishment:
The position for the center one-quarter corner,
Section 21, Township 32 South, Range 3 East, Willamette
Meridian, Jackson County, Oregon, was established by C.
Z. Boyden (former Deputy Jackson County Surveyor) on
September 7, 1929.

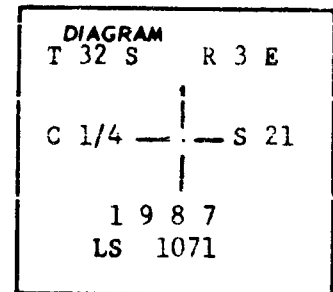

Description of corner evidence found:

At the corner position, I found two remaining accessories:

A 52-inch diameter, 4-foot tall fir stump, bears (County record) N.20°45'W., 9.1 feet distance, with a healed blaze.

An 18-inch diameter fir bears (County record) S.17°45'E., 36.5 feet distance, with a healed blaze (basis of bearing).

Description of monument and accessories I established to perpetuate the original location of this corner

At the corner point, as determined by the distances from the found original accessories, I set a 2 1/2-inch diameter by 30-inch long iron post, with a 2 1/2-inch diameter brass cap marked as shown in the diagram, and mark an additional accessory as required.

A 7-inch diameter cedar bears N.16°00'E., 20.0 feet distance, scribed C 1/4 S 21 LS 1071 BT.

January 22, 1987

HAROLD L. CENTER
Registered Professional Land Surveyor
Oregon Certificate No. 1071

REGISTERED
PROFESSIONAL
LAND SURVEYOR

OREGON
HAROLD L. CENTER
REG. NO. 1071
No. 1071

Office of County of
State of , I hereby certify that the within instrument was filed in this office
for record on the day of; 19....., at o'clock m., (signed)
..... by
(COUNTY OFFICIAL) (DEPUTY)

SURVEY NARRATIVE TO COMPLY WITH
PARAGRAPH 209.250 OREGON REVISED STATUTES

SURVEY FOR: Rogue River National Forest
P. O. Box 520
Medford, OR 97501

LOCATION: Section 21, Township 32 South, Range 3 East,
Willamette Meridian, Jackson County, Oregon.

PURPOSE: To preserve and protect deteriorating corner evidence.

PROCEDURE: Utilizing existing corner evidence recovered at the
corner point, I verified the corner point from
recovered accessories, stabilized the monument and
marked additional accessories as required to
perpetuate the corner point.

BASIS OF BEARING: Compass Bearing: County Surveyor accessory marked
September 7, 1929

DATE: January 22, 1987

HAROLD L. CENTER
Registered Professional Land Surveyor
Oregon Certificate No. 1071

